


NOTES

- All Sewer Main Pipes are Ø160 PE21 PE100 Class SDR21, Unless noted otherwise.
- All Sewer House Connections are Ø110 PE, Unless noted otherwise.

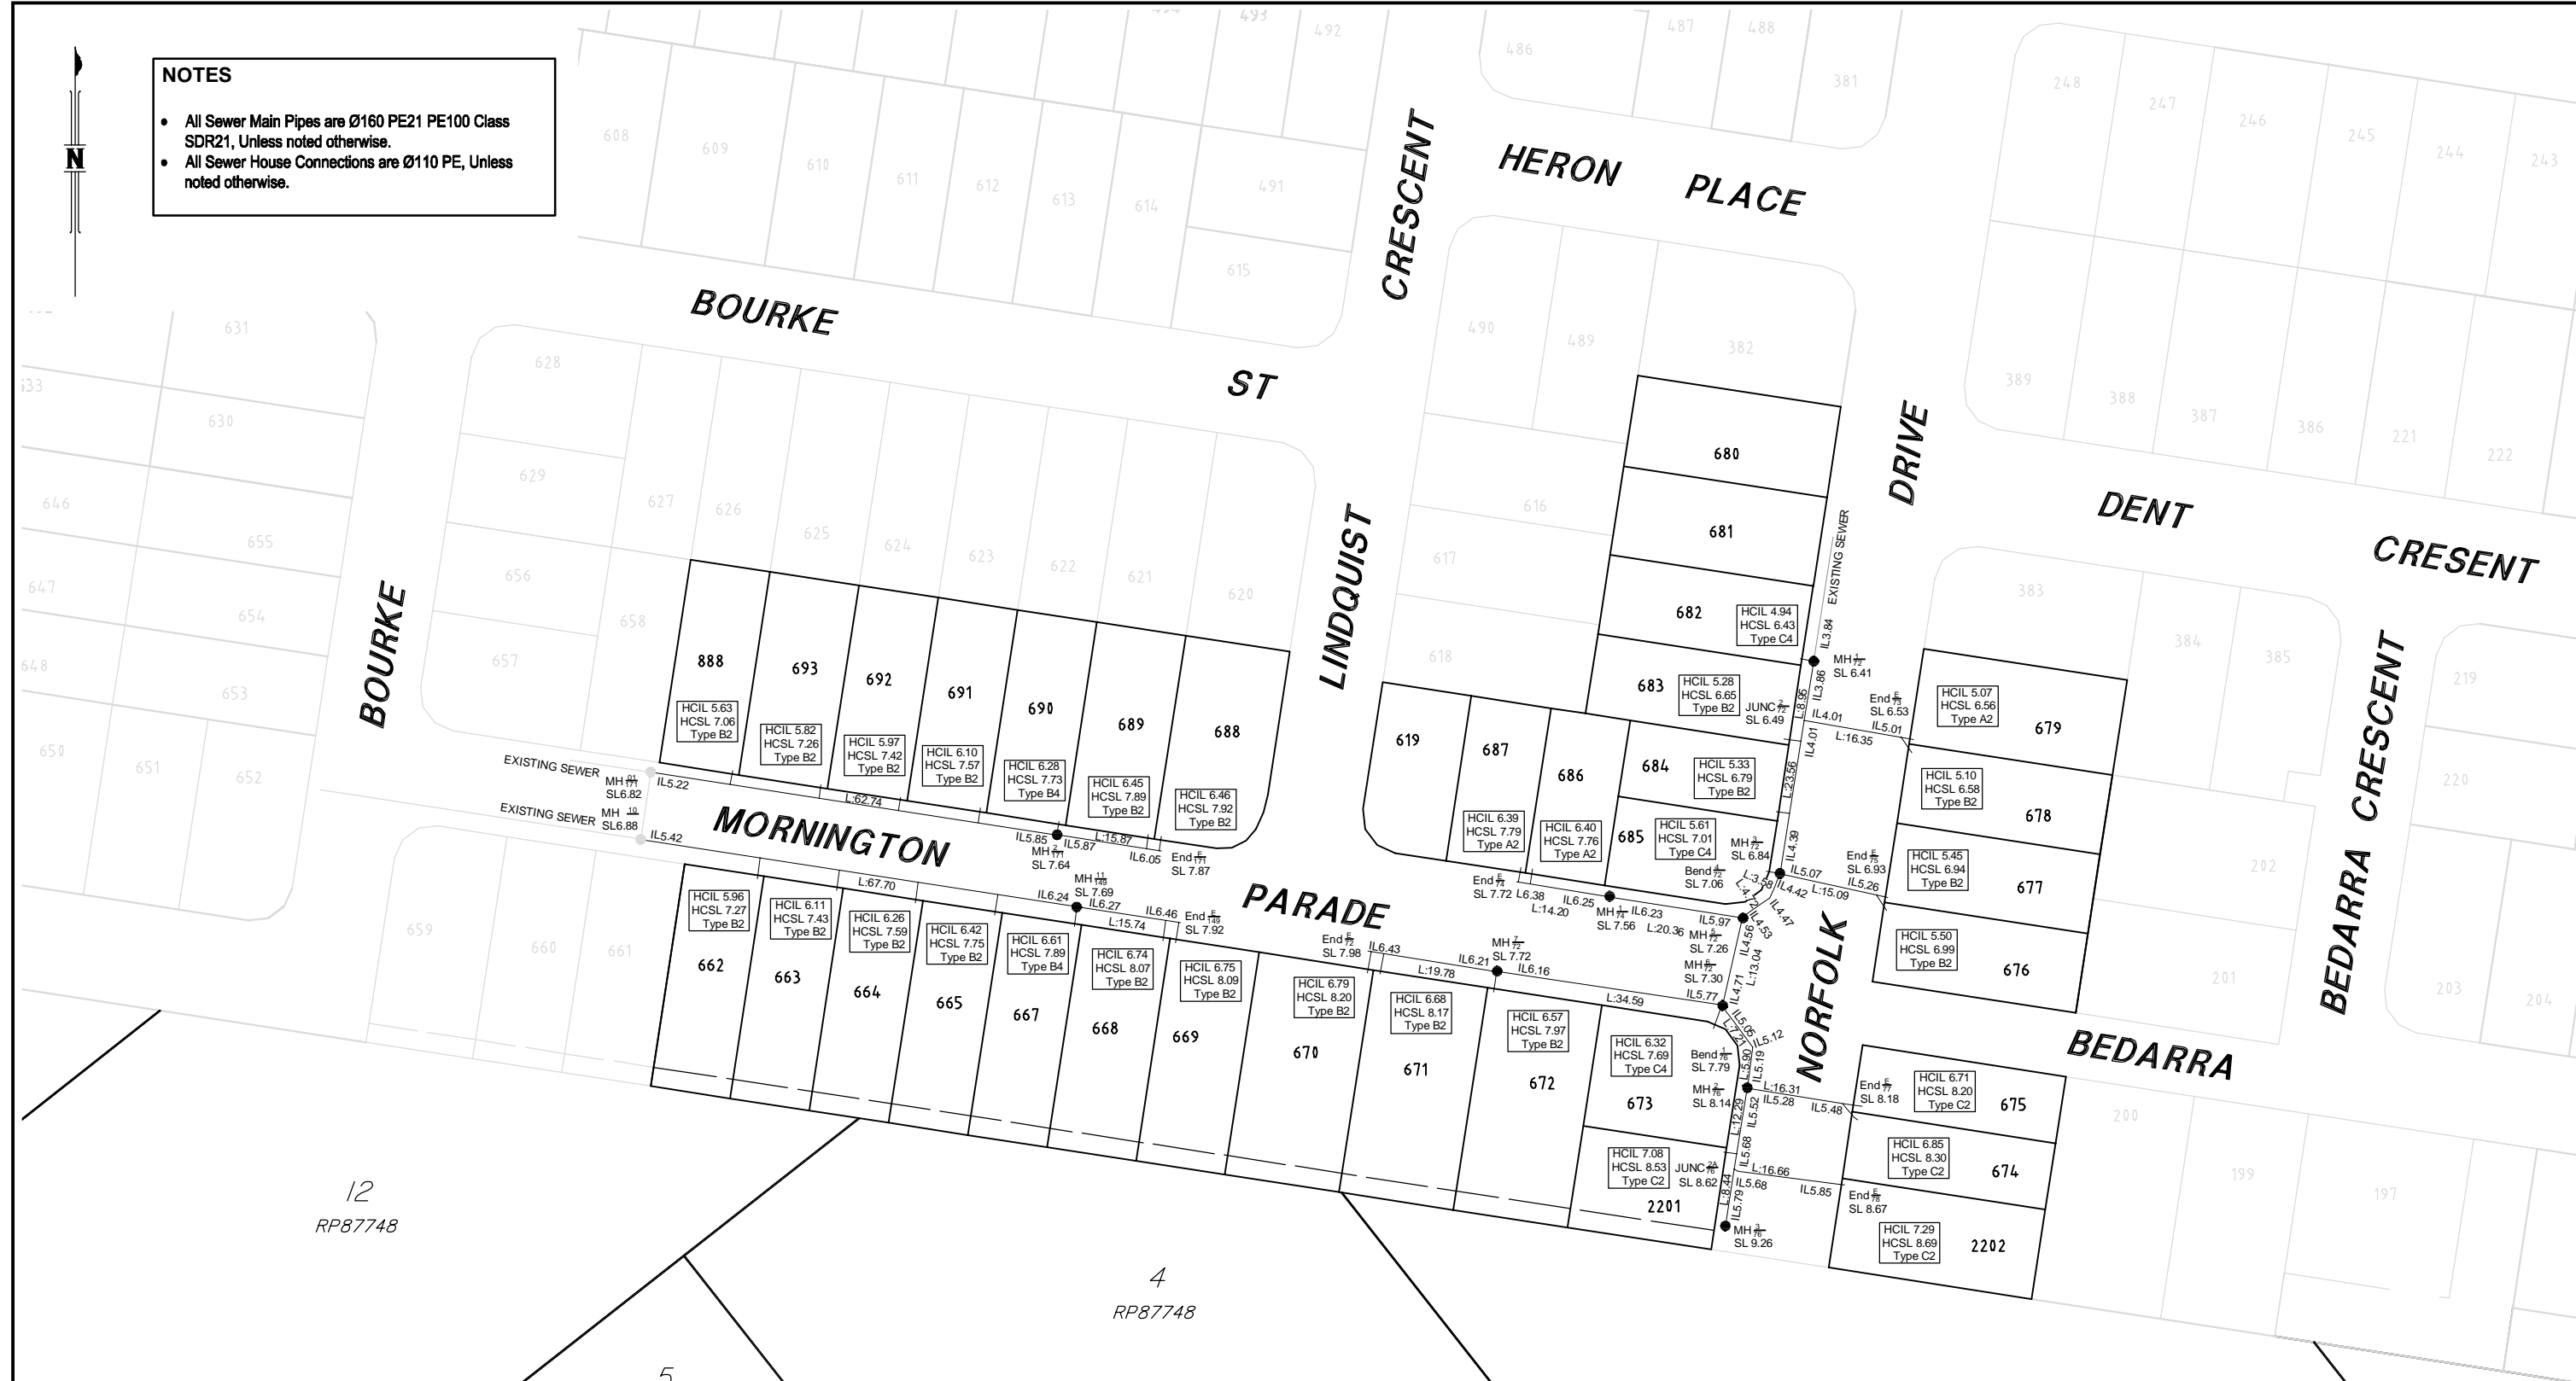


12
RP87748

4
RP87748

5
RP87748

3
RP87748

AS CONSTRUCTED

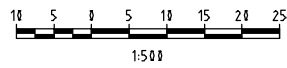

ENGINEER'S CERTIFICATION

I, MARK SHAW being a certified / registered engineer and duly authorised representative of KN GROUP PTY LTD hereby:

- Certify the information contained in the drawing is an accurate "AS CONSTRUCTED" representation of the works.
- Accept responsibility for the "AS CONSTRUCTED" information contained in this drawing.
- Acknowledge the "AS CONSTRUCTED" information contained in drawing may be relied on by Council and others.

Certification by _____ on _____
for KN GROUP PTY LTD.
Registered Professional Engineer of Queensland - No. 17544

SURVEYOR'S CERTIFICATION

We T.H. JENSEN BOWERS PTY LTD, hereby certify that the vertical and horizontal locations and dimensions shown on this plan are a true and correct record and were located by survey.

Director _____ Date: 02/10/18

A1

INDEX	DATE	REVISIONS	DRAWN	CHECKED	PASSED	INITIALS	DATE
A	11/09/18	Original Issue	LB	JM			

DRAWN	LB	11/09/18
CHECKED	JM	12/09/18
PASSED		

JENSEN BOWERS
SURVEYORS PLANNERS DEVELOPMENT ADVISORS
jensenbowers.com.au

72 Costin Street, Fortitude Valley, QLD 4006
PO Box 798, Spring Hill, QLD 4004
T: (07) 3852 1771 F: (07) 3252 9818
T.H. Jensen & Bowers Pty. Ltd. (Consulting Surveyors)
ABN: 52 010 97269
© Copyright reserved to Jensen Bowers Group Consultants Pty Ltd



Unitywater

NORTHEAST BUSINESS PARK C/ - KN GROUP PTY LTD CONSULTING ENGINEERS
NORTH HARBOUR - STAGE 22
AS CONSTRUCTED SEWER RETICULATION

SHEET 1 OF 1 SHEETS	SCALE 1:500
REVISION DATE 11/09/18	REVISION A
DISCIPLINE CODE	
DRAWING NO. U-2018-0666	