

NOTES

- All Sewer Main Pipes are Ø160 PE21 PE100 Class SDR21, Unless noted otherwise.
- All Sewer House Connections are Ø110 PE, Unless noted otherwise.




2000
SP288120

MORETON BAY BOULEVARD

DENHAM PLACE

NORMANBY

PALM CLOSE

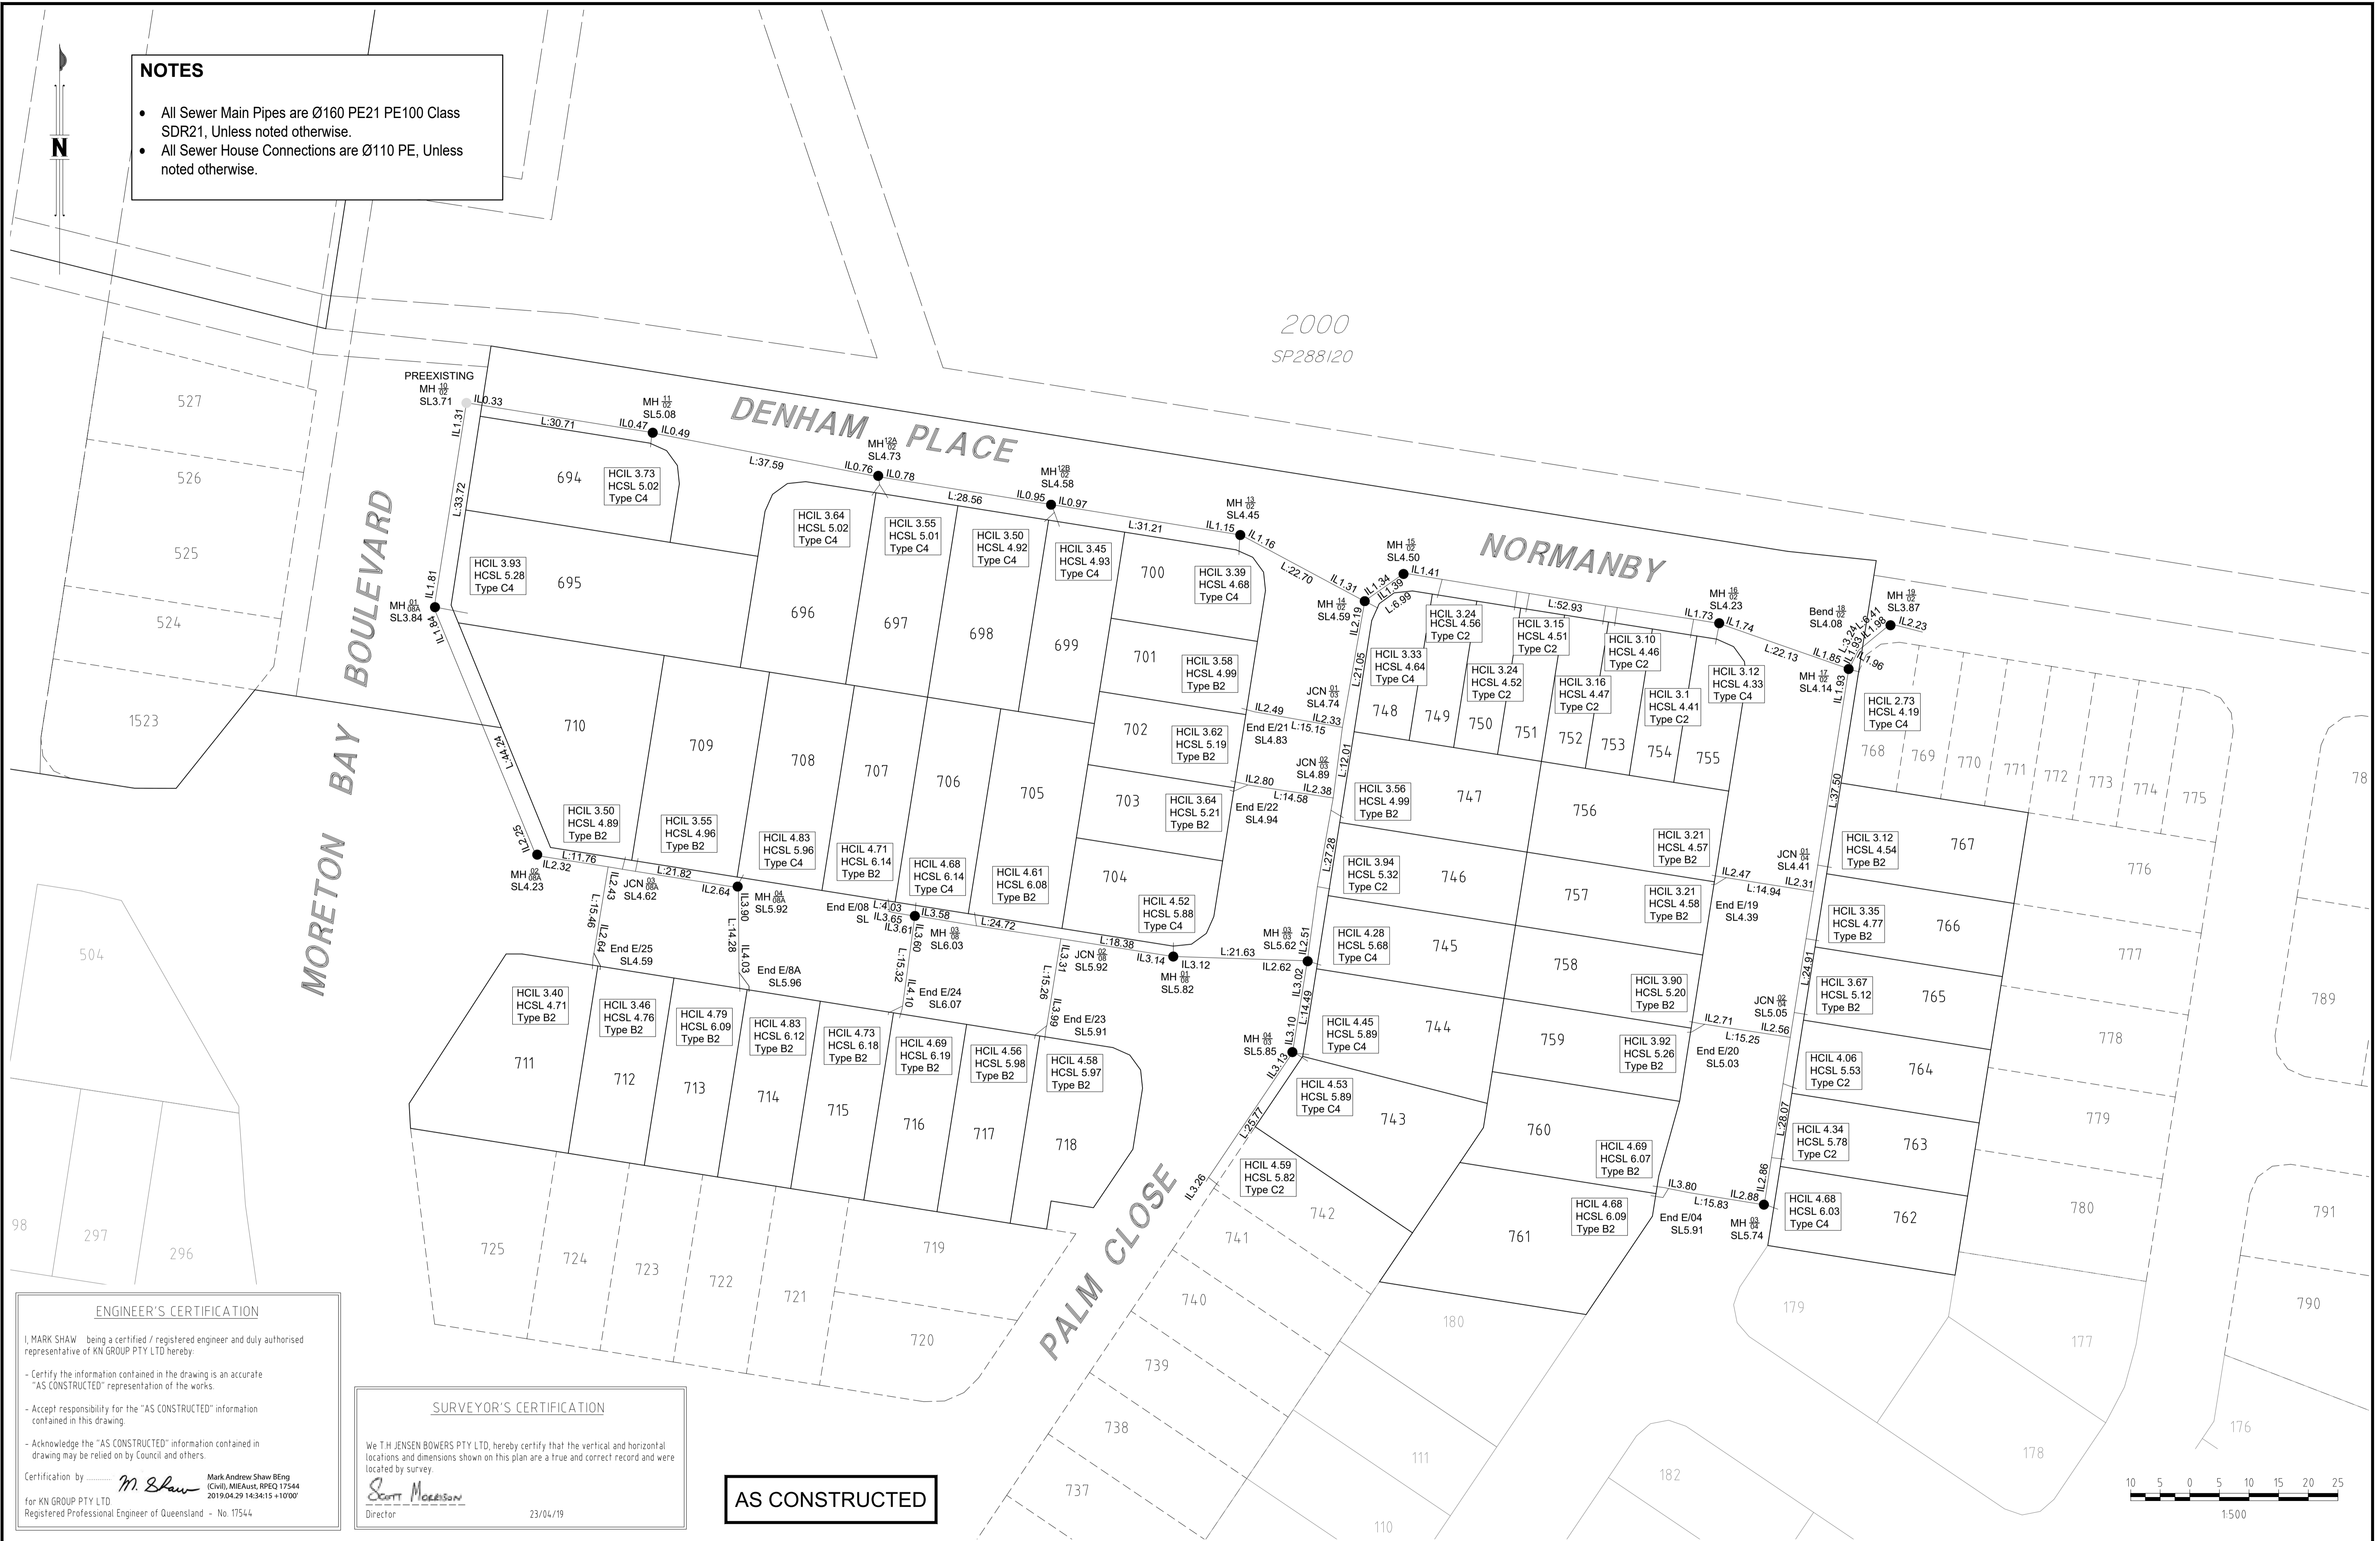

ENGINEER'S CERTIFICATION

I, MARK SHAW being a certified / registered engineer and duly authorised representative of KN GROUP PTY LTD hereby:

- Certify the information contained in the drawing is an accurate "AS CONSTRUCTED" representation of the works.

- Accept responsibility for the "AS CONSTRUCTED" information contained in this drawing.

- Acknowledge the "AS CONSTRUCTED" information contained in drawing may be relied on by Council and others.


Certification by Mark Shaw Mark Andrew Shaw BEng (Civil), MIEAust, RPCE 17544 2019.04.29 14:34:15 +1000 for KN GROUP PTY LTD Registered Professional Engineer of Queensland - No. 17544

SURVEYOR'S CERTIFICATION

We T.H. JENSEN BOWERS PTY LTD, hereby certify that the vertical and horizontal locations and dimensions shown on this plan are a true and correct record and were located by survey.

Scott Morrison Director 23/04/19


AS CONSTRUCTED

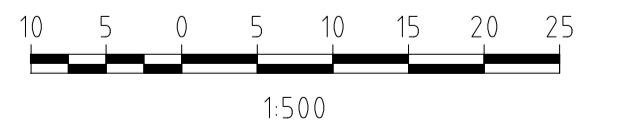

A1

INDEX	DATE	REVISIONS	DRAWN	CHECKED	PASSED
A	23/04/19	Original Issue	LB	SM	SM

DRAWN	LB	16/04/19
CHECKED	SM	23/04/19
PASSED	SM	23/04/19
INITIALS		DATE

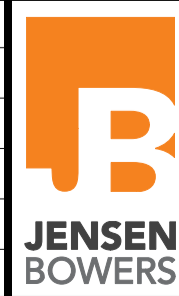

SURVEYORS PLANNERS DEVELOPMENT ADVISORS
jensenbowers.com.au

72 Costin Street, Fortitude Valley, Qld. 4006
PO Box 799, Spring Hill, Qld. 4004
T: (07) 3852 1771 F: (07) 3252 9818
T.H. Jensen & Bowers Pty. Ltd. (Consulting Surveyors)
ABN: 52 010 872 607
©Copyright reserved to Jensen Bowers Group Consultants Pty Ltd



Unitywater

NORTHEAST BUSINESS PARK C/ - KN GROUP PTY LTD CONSULTING ENGINEERS
NORTH HARBOUR - STAGE 34
AS CONSTRUCTED SEWER RETICULATION

SHEET 1 OF 1 SHEETS	SCALE 1:500
REVISION DATE 23/04/19	REVISION A
DISCIPLINE CODE	
DRAWING NO. U-2018-0866	