





- NOTES**
- All Sewer Main Pipes are Ø160 PE21 PE100 Class SDR21, unless noted otherwise.
 - All Sewer House Connections are Ø110 PE, unless noted otherwise.

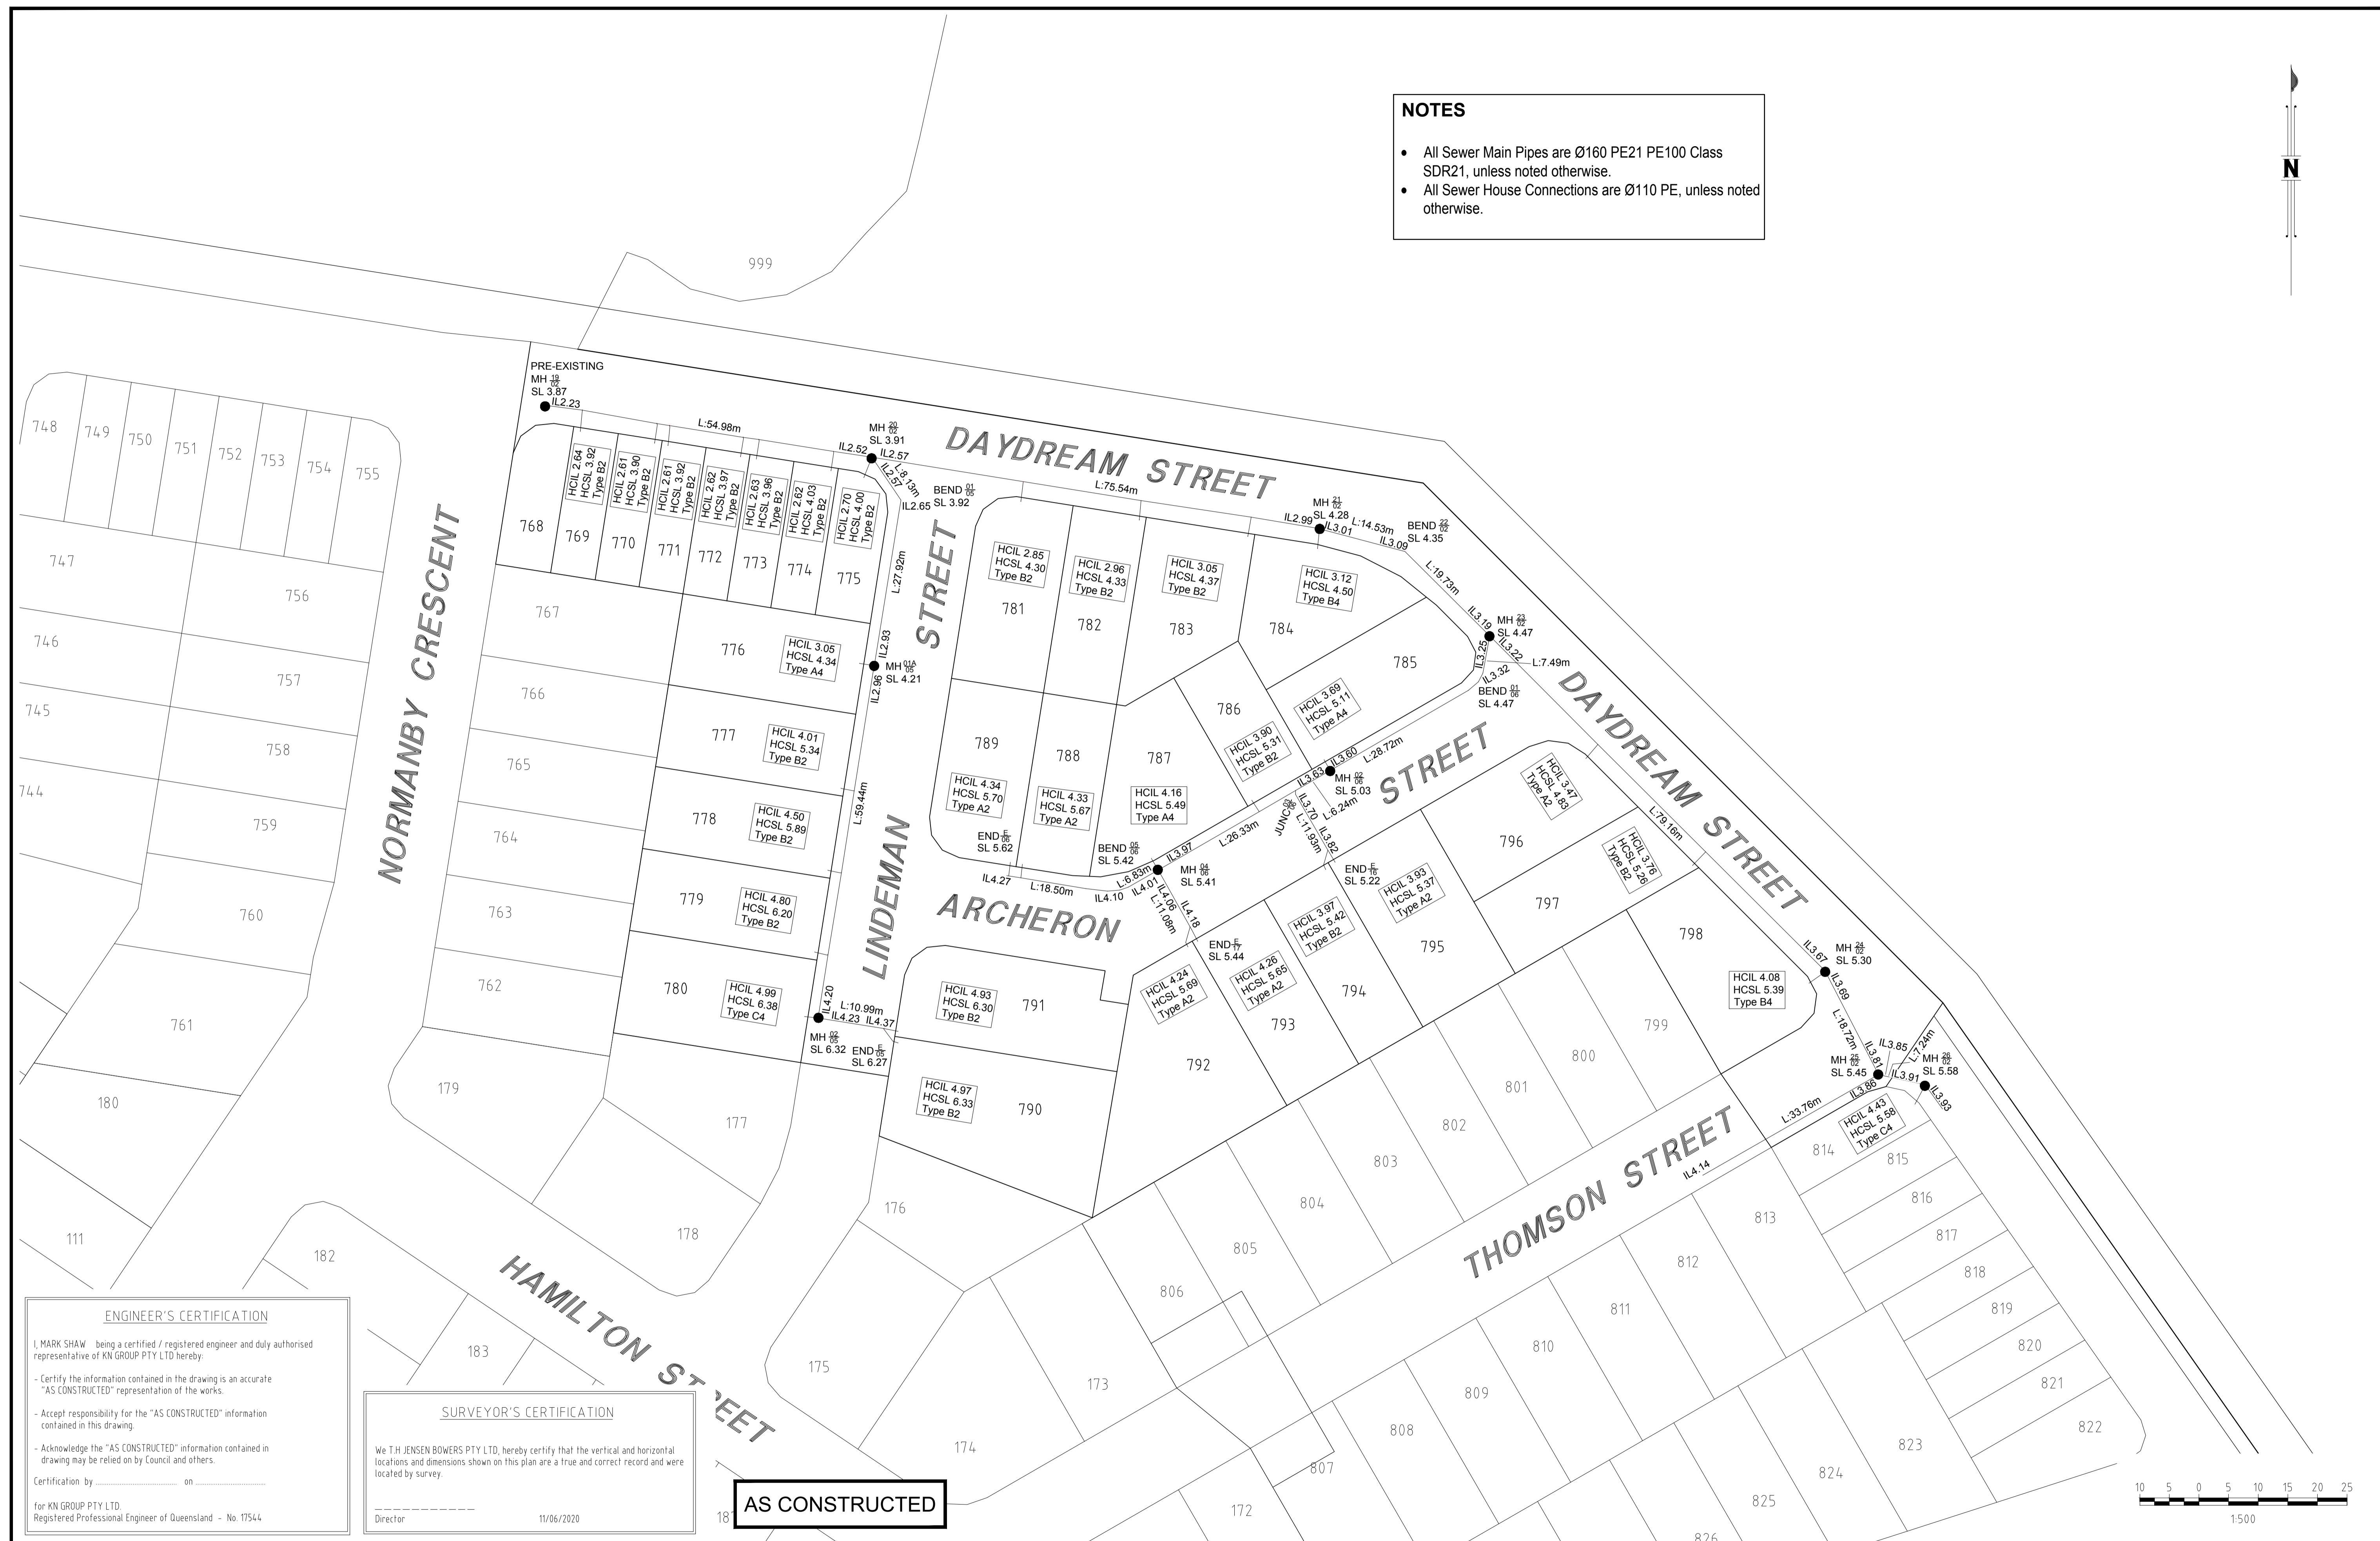

AS CONSTRUCTED

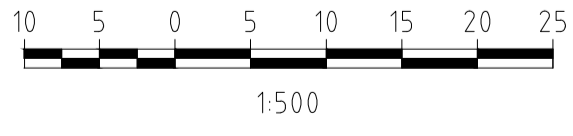

ENGINEER'S CERTIFICATION

I, MARK SHAW being a certified / registered engineer and duly authorised representative of KN GROUP PTY LTD hereby:

- Certify the information contained in the drawing is an accurate "AS CONSTRUCTED" representation of the works.
- Accept responsibility for the "AS CONSTRUCTED" information contained in this drawing.
- Acknowledge the "AS CONSTRUCTED" information contained in drawing may be relied on by Council and others.

Certification by _____ on _____

for KN GROUP PTY LTD.
Registered Professional Engineer of Queensland - No. 17544

SURVEYOR'S CERTIFICATION

We T.H. JENSEN BOWERS PTY LTD, hereby certify that the vertical and horizontal locations and dimensions shown on this plan are a true and correct record and were located by survey.

Director _____ 11/06/2020

DRAWN	JB	11/06/2020	<p>JENSEN BOWERS SURVEYORS PLANNERS DEVELOPMENT ADVISORS jensenbowers.com.au</p>
CHECKED	SM	11/06/2020	
PASSED	SM	11/06/2020	
INITIALS	DATE		



Unitywater

NORTHEAST BUSINESS PARK C/ - KN GROUP PTY LTD CONSULTING ENGINEERS
NORTH HARBOUR - STAGE 36
AS CONSTRUCTED SEWER RETICULATION

SHEET 1 OF 1 SHEETS	SCALE 1:500
REVISION DATE 11/06/2020	REVISION A
DRAWING NO. U-<TBA ENGINEERS>	

A1

INDEX	DATE	REVISIONS	DRAWN	CHECKED	PASSED
A	11/06/2020	Original Issue	JB	SM	SM