


LEGEND

- ∅ Pipe Diameter
- Fire Hydrant
- Temporary Hydrant/End
- ⊗ Valve
- ① 11.25° BEND
- ② 22.5° BEND
- ③ 45° BEND
- ④ 90° BEND
- ⊕ Ready Tap
- Water Meter
- Water Crossing
- Water Main
- DICL Water Main

NOTES

- Water main pipes are Ø150 PVC-0 Class PN16 unless noted otherwise.
- All road crossings are Ø150 DICL Class DN35 unless noted otherwise.

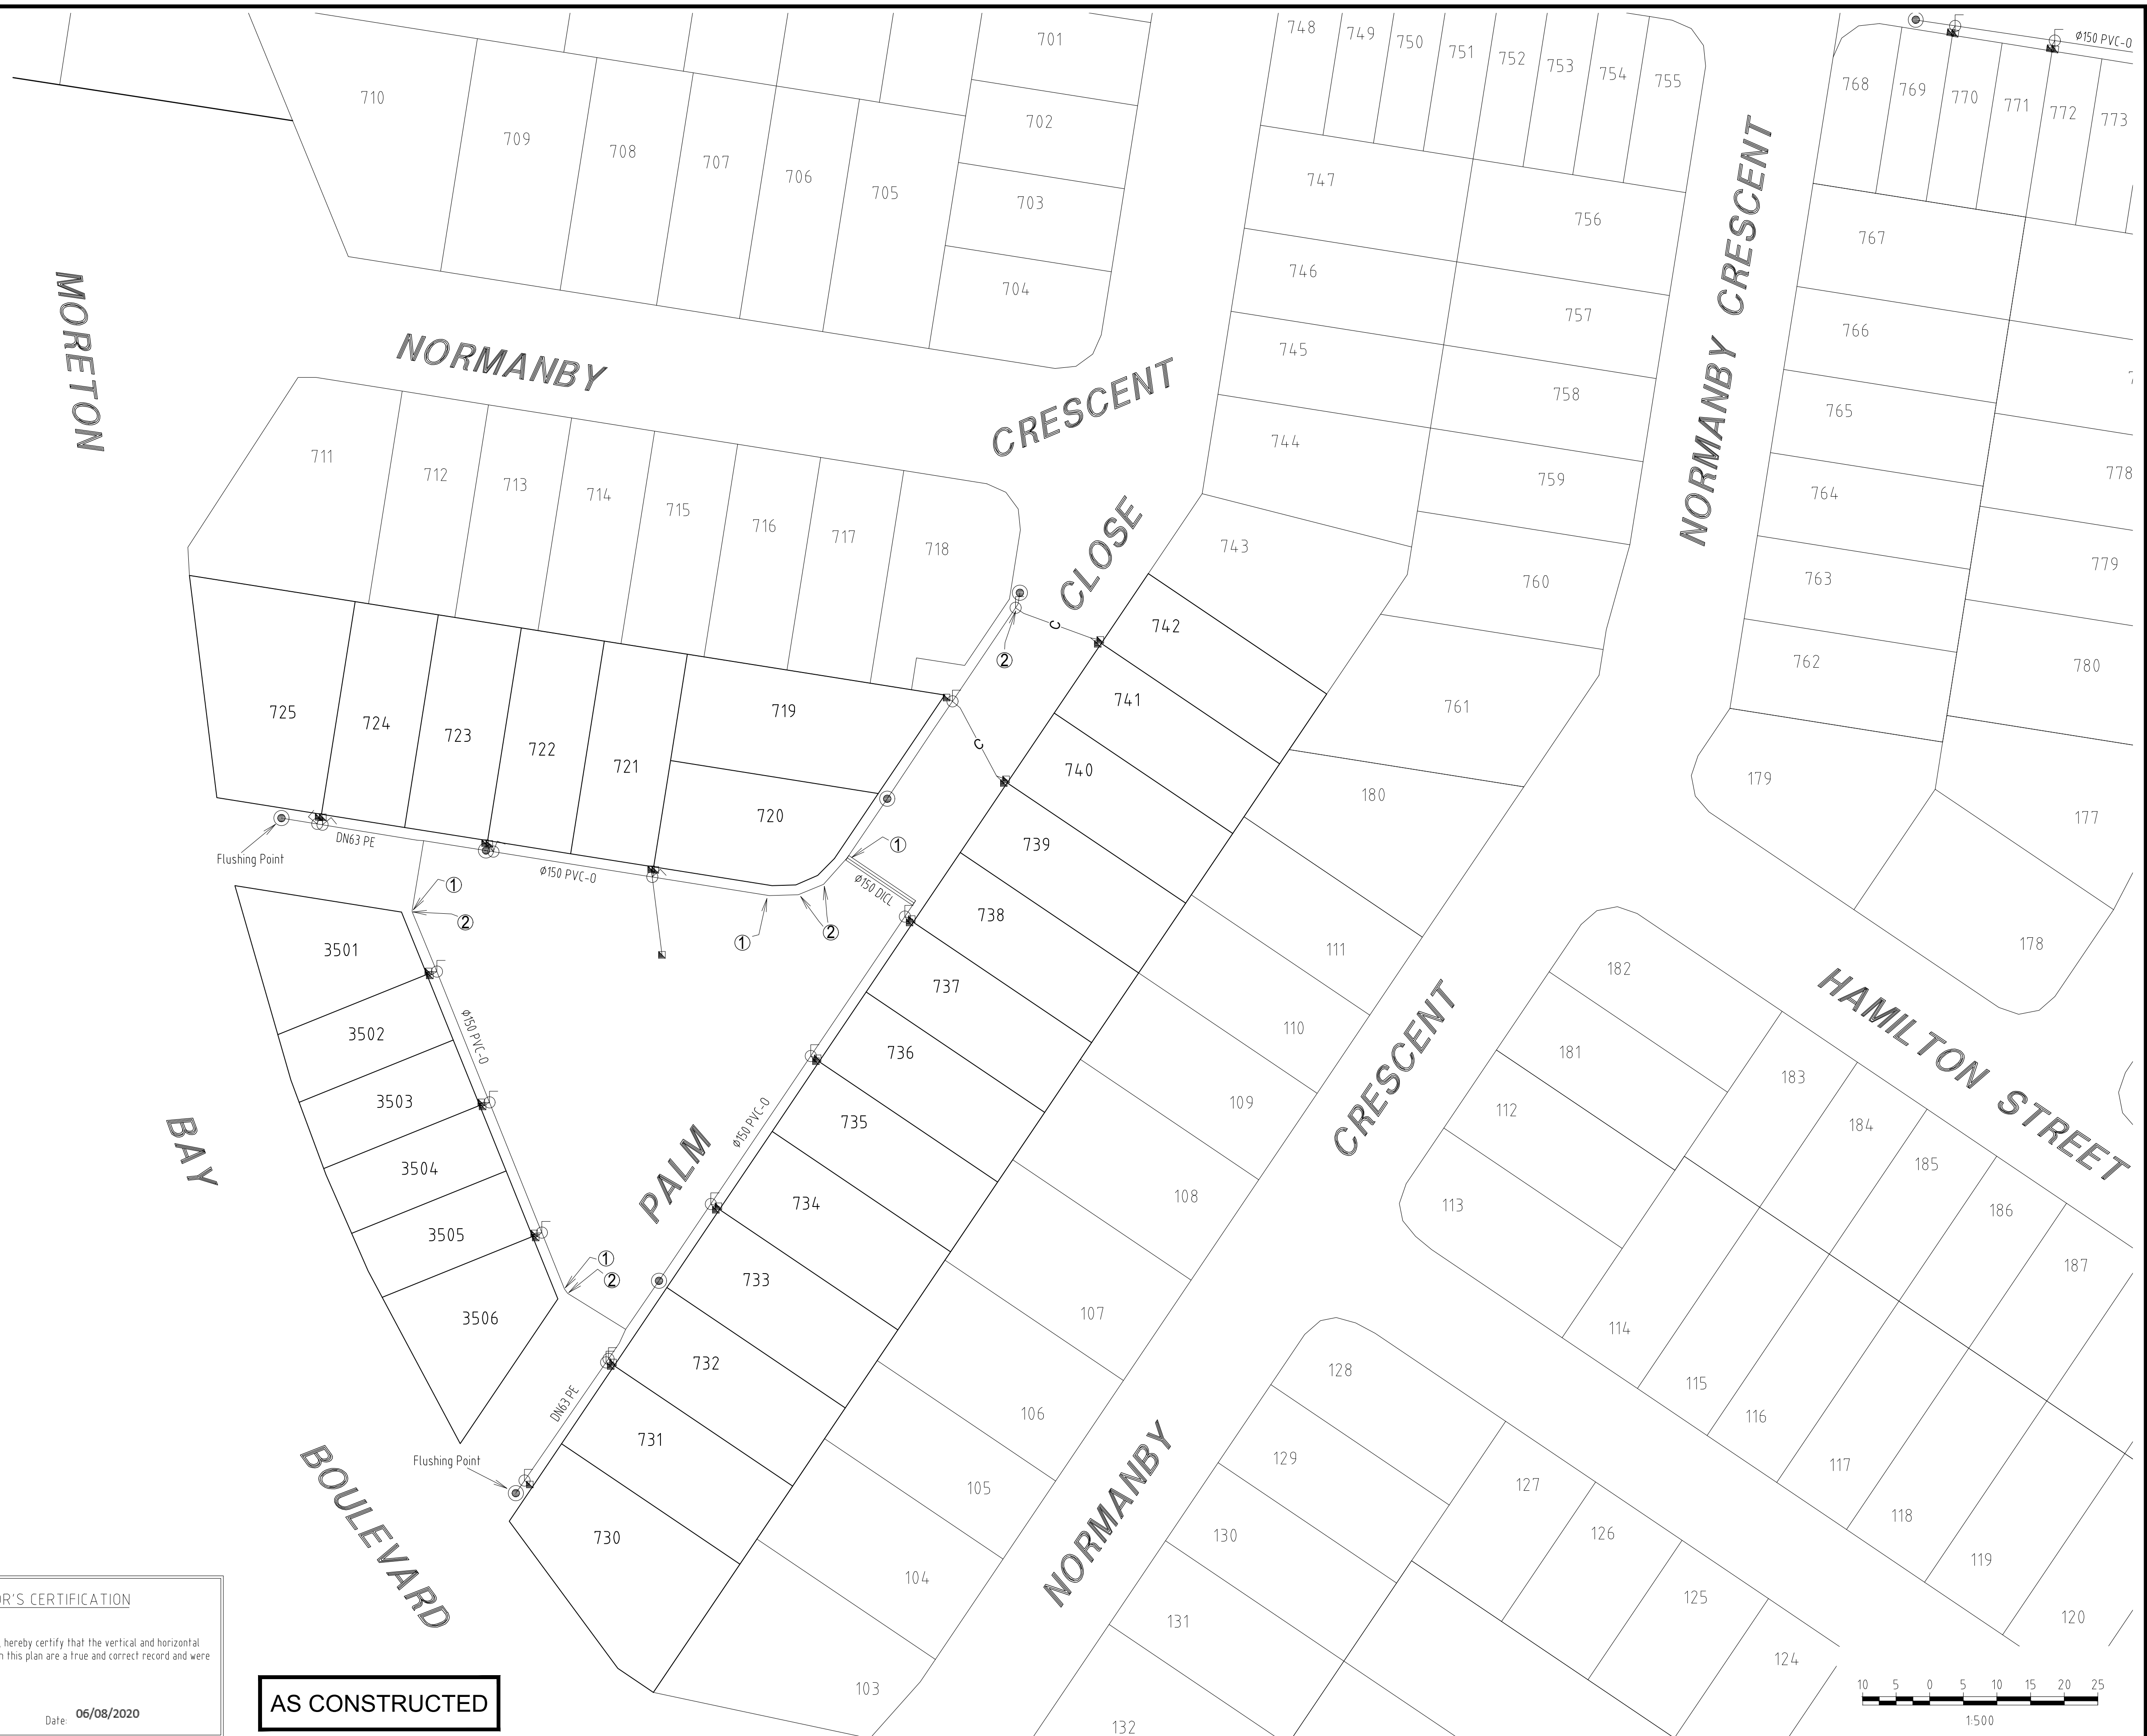

ENGINEER'S CERTIFICATION

I, MARK SHAW being a certified / registered engineer and duly authorised representative of KN GROUP PTY LTD hereby:

- Certify the information contained in the drawing is an accurate "AS CONSTRUCTED" representation of the works.

- Accept responsibility for the "AS CONSTRUCTED" information contained in this drawing.

- Acknowledge the "AS CONSTRUCTED" information contained in drawing may be relied on by Council and others.

Certification by _____ on _____

for KN GROUP PTY LTD.
Registered Professional Engineer of Queensland - No. 17544

SURVEYOR'S CERTIFICATION

We T.H. JENSEN BOWERS PTY LTD, hereby certify that the vertical and horizontal locations and dimensions shown on this plan are a true and correct record and were located by survey.

Scott Mackinnon
Director Date: 06/08/2020

AS CONSTRUCTED

A1

INDEX	DATE	REVISIONS	DRAWN	CHECKED	PASSED
A	07/07/2020	Original Issue	EC	DB	DB

DRAWN	EC	07/07/2020	JENSEN BOWERS
CHECKED	DB	07/07/2020	
PASSED	DB	07/07/2020	

SURVEYORS PLANNERS DEVELOPMENT ADVISORS
jensenbowers.com.au

72 Coatin Street, Fortitude Valley, Qld. 4006
PO Box 790, Spring Hill, Qld. 4004
T: 071 3852 1771 F: 071 3852 9818
T.H. Jensen & Bowers Pty. Ltd. (Consulting Surveyors)
ABN: 52 010 812 607
© Copyright reserved to Jensen Bowers Group Consultants Pty Ltd



Unitywater
07/07/2020
NORTHEAST BUSINESS PARK C/ - KN GROUP PTY LTD CONSULTING ENGINEERS
NORTH HARBOUR - STAGE 35
AS CONSTRUCTED WATER RETICULATION

SHEET 1 OF 1 SHEETS	SCALE 1:500
REVISION DATE 7/07/20	REVISION A
DRAWING NO. U-2020-0280	