

Legend

	Road Kerb Invert
	Bottom of Bank
	Top of Bank
	Change of Grade
	Retaining Wall
	Contour Major
	Contour Minor
	Fence Line
	Concrete Path
	Surface Level

ENGINEER'S CERTIFICATION

I, MARK SHAW being a certified / registered engineer and duly authorised representative of KN GROUP PTY LTD hereby:

- Certify the information contained in the drawing is an accurate "AS CONSTRUCTED" representation of the works.
- Accept responsibility for the "AS CONSTRUCTED" information contained in this drawing.
- Acknowledge the "AS CONSTRUCTED" information contained in drawing may be relied on by Council and others.

Certification by _____ on _____
for KN GROUP PTY LTD.
Registered Professional Engineer of Queensland - No. 17544

SURVEYOR'S CERTIFICATION

We T.H. JENSEN BOWERS PTY LTD, hereby certify that the vertical and horizontal locations and dimensions shown on this plan are a true and correct record and were located by survey.

Director Date: 10/11/2020



JENSEN BOWERS SURVEYORS PLANNERS DEVELOPMENT ADVISORS
jensenbowers.com.au

72 Costin Street, Fortitude Valley, Qld. 4006
PO Box 799, Spring Hill, Qld. 4004
T (07) 3852 1771 F (07) 3252 9818


T.H. Jensen & Bowers Pty. Ltd. (Consulting Surveyors)
ABN. 52 010 872 607

© Copyright reserved to Jensen Bowers Group Consultants Pty Ltd

Associated Consultants

Local Authority: Morton Bay Regional Council
Authority Ref. No:
RP Description: Lots 768-798 on SP288124

Original Portion:
Date of Survey: 12/06/20
Level Datum: AHD (der)
Origin: OPM72418 (RL 14.859m)
Level Bk / Fld Bk: Digital
Horizontal Datum: SP288124
Contour Interval: 0.25m

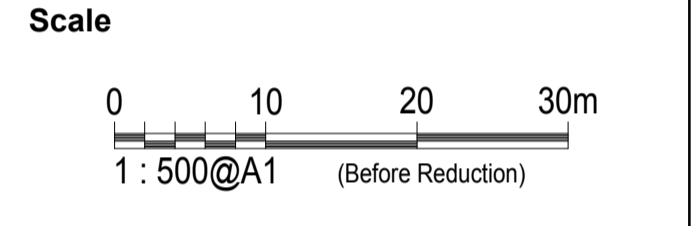

The services shown hereon have been located where possible by field survey. Whilst due care and attention have been exercised, T.H. Jensen and Bowers Pty. Ltd. does not warrant that the services have been located in their entirety.

The boundaries shown hereon are for plotting purposes only and are subject to final survey.

Disclaimer

Any licence, expressed or implied, to use this document for any purpose whatsoever is restricted to the terms of the agreement or implied agreement between Jensen Bowers and the instructing party.

Drawn: EC	25/09/2020
Surveyed: JB	07/09/2020
Checked: SM	Date: 28/09/2020
Approved:	

Issue	Description	Date	Appd.
A	Original Issue	28/09/20	DB

Client
Northeast Business Park Pty Ltd

**North Harbour
Buckley Road
Burpengary East**

**As Constructed
Finished Surface
Stage 37**

Drawing No.	Issue	Original Size
S-7550-285	A	A1