

**NOTES**

- All Sewer Main Pipes are Ø160 PE21 PE100 Class SDR21, unless noted otherwise.
- All Sewer House Connections are Ø110 PE, unless noted otherwise.

**ENGINEER'S CERTIFICATION**

I, MARK SHAW being a certified / registered engineer and duly authorised representative of KN GROUP PTY LTD hereby:

- Certify the information contained in the drawing is an accurate "AS CONSTRUCTED" representation of the works.
- Accept responsibility for the "AS CONSTRUCTED" information contained in this drawing.
- Acknowledge the "AS CONSTRUCTED" information contained in drawing may be relied on by Council and others.

Certification by \_\_\_\_\_ on \_\_\_\_\_

for KN GROUP PTY LTD.  
Registered Professional Engineer of Queensland - No. 17544


**SURVEYOR'S CERTIFICATION**

We T.H. JENSEN BOWERS PTY LTD, hereby certify that the vertical and horizontal locations and dimensions shown on this plan are a true and correct record and were located by survey.

*[Signature]*

Director 16/02/2021

**AS CONSTRUCTED**

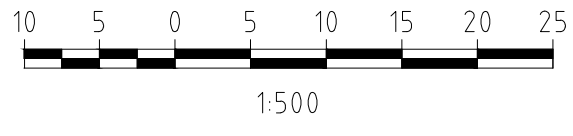

<b>A1</b>	C	16/02/2021	Amendments	EC	SM	SM	DRAWN	JB	11/12/2020
	B	15/02/2021	Amendments	JB	SM	SM	CHECKED	SM	11/12/2020
	A	11/12/2020	Original Issue	JB	SM	SM	PASSED	SM	11/12/2020
	INDEX	DATE	REVISIONS	DRAWN	CHECKED	PASSED	INITIALS	DATE	

**JENSEN BOWERS**

**SURVEYORS PLANNERS DEVELOPMENT ADVISORS**

72 Costin Street, Fortitude Valley, Qld. 4006  
PO Box 799, Spring Hill, Qld. 4004  
T (07) 3855 1771 F (07) 3252 9818  
T.H. Jensen & Bowers Pty. Ltd. (Consulting Surveyors)  
ABN: 52 010 872 607  
© Copyright reserved to Jensen Bowers Group Consultants Pty Ltd



**Unitywater**

NORTHEAST BUSINESS PARK C/ - KN GROUP PTY LTD CONSULTING ENGINEERS  
NORTH HARBOUR - STAGE 44  
AS CONSTRUCTED SEWER RETICULATION

SHEET 1 OF 1 SHEETS	SCALE 1:500
REVISION DATE 15/02/2021	REVISION C
DRAWING NO. U-<TBA ENGINEERS>	