


**NOTES**

- All Sewer Main Pipes are Ø160 PE21 PE100 Class SDR21, unless noted otherwise.
- All Sewer House Connections are Ø110 PE, unless noted otherwise.

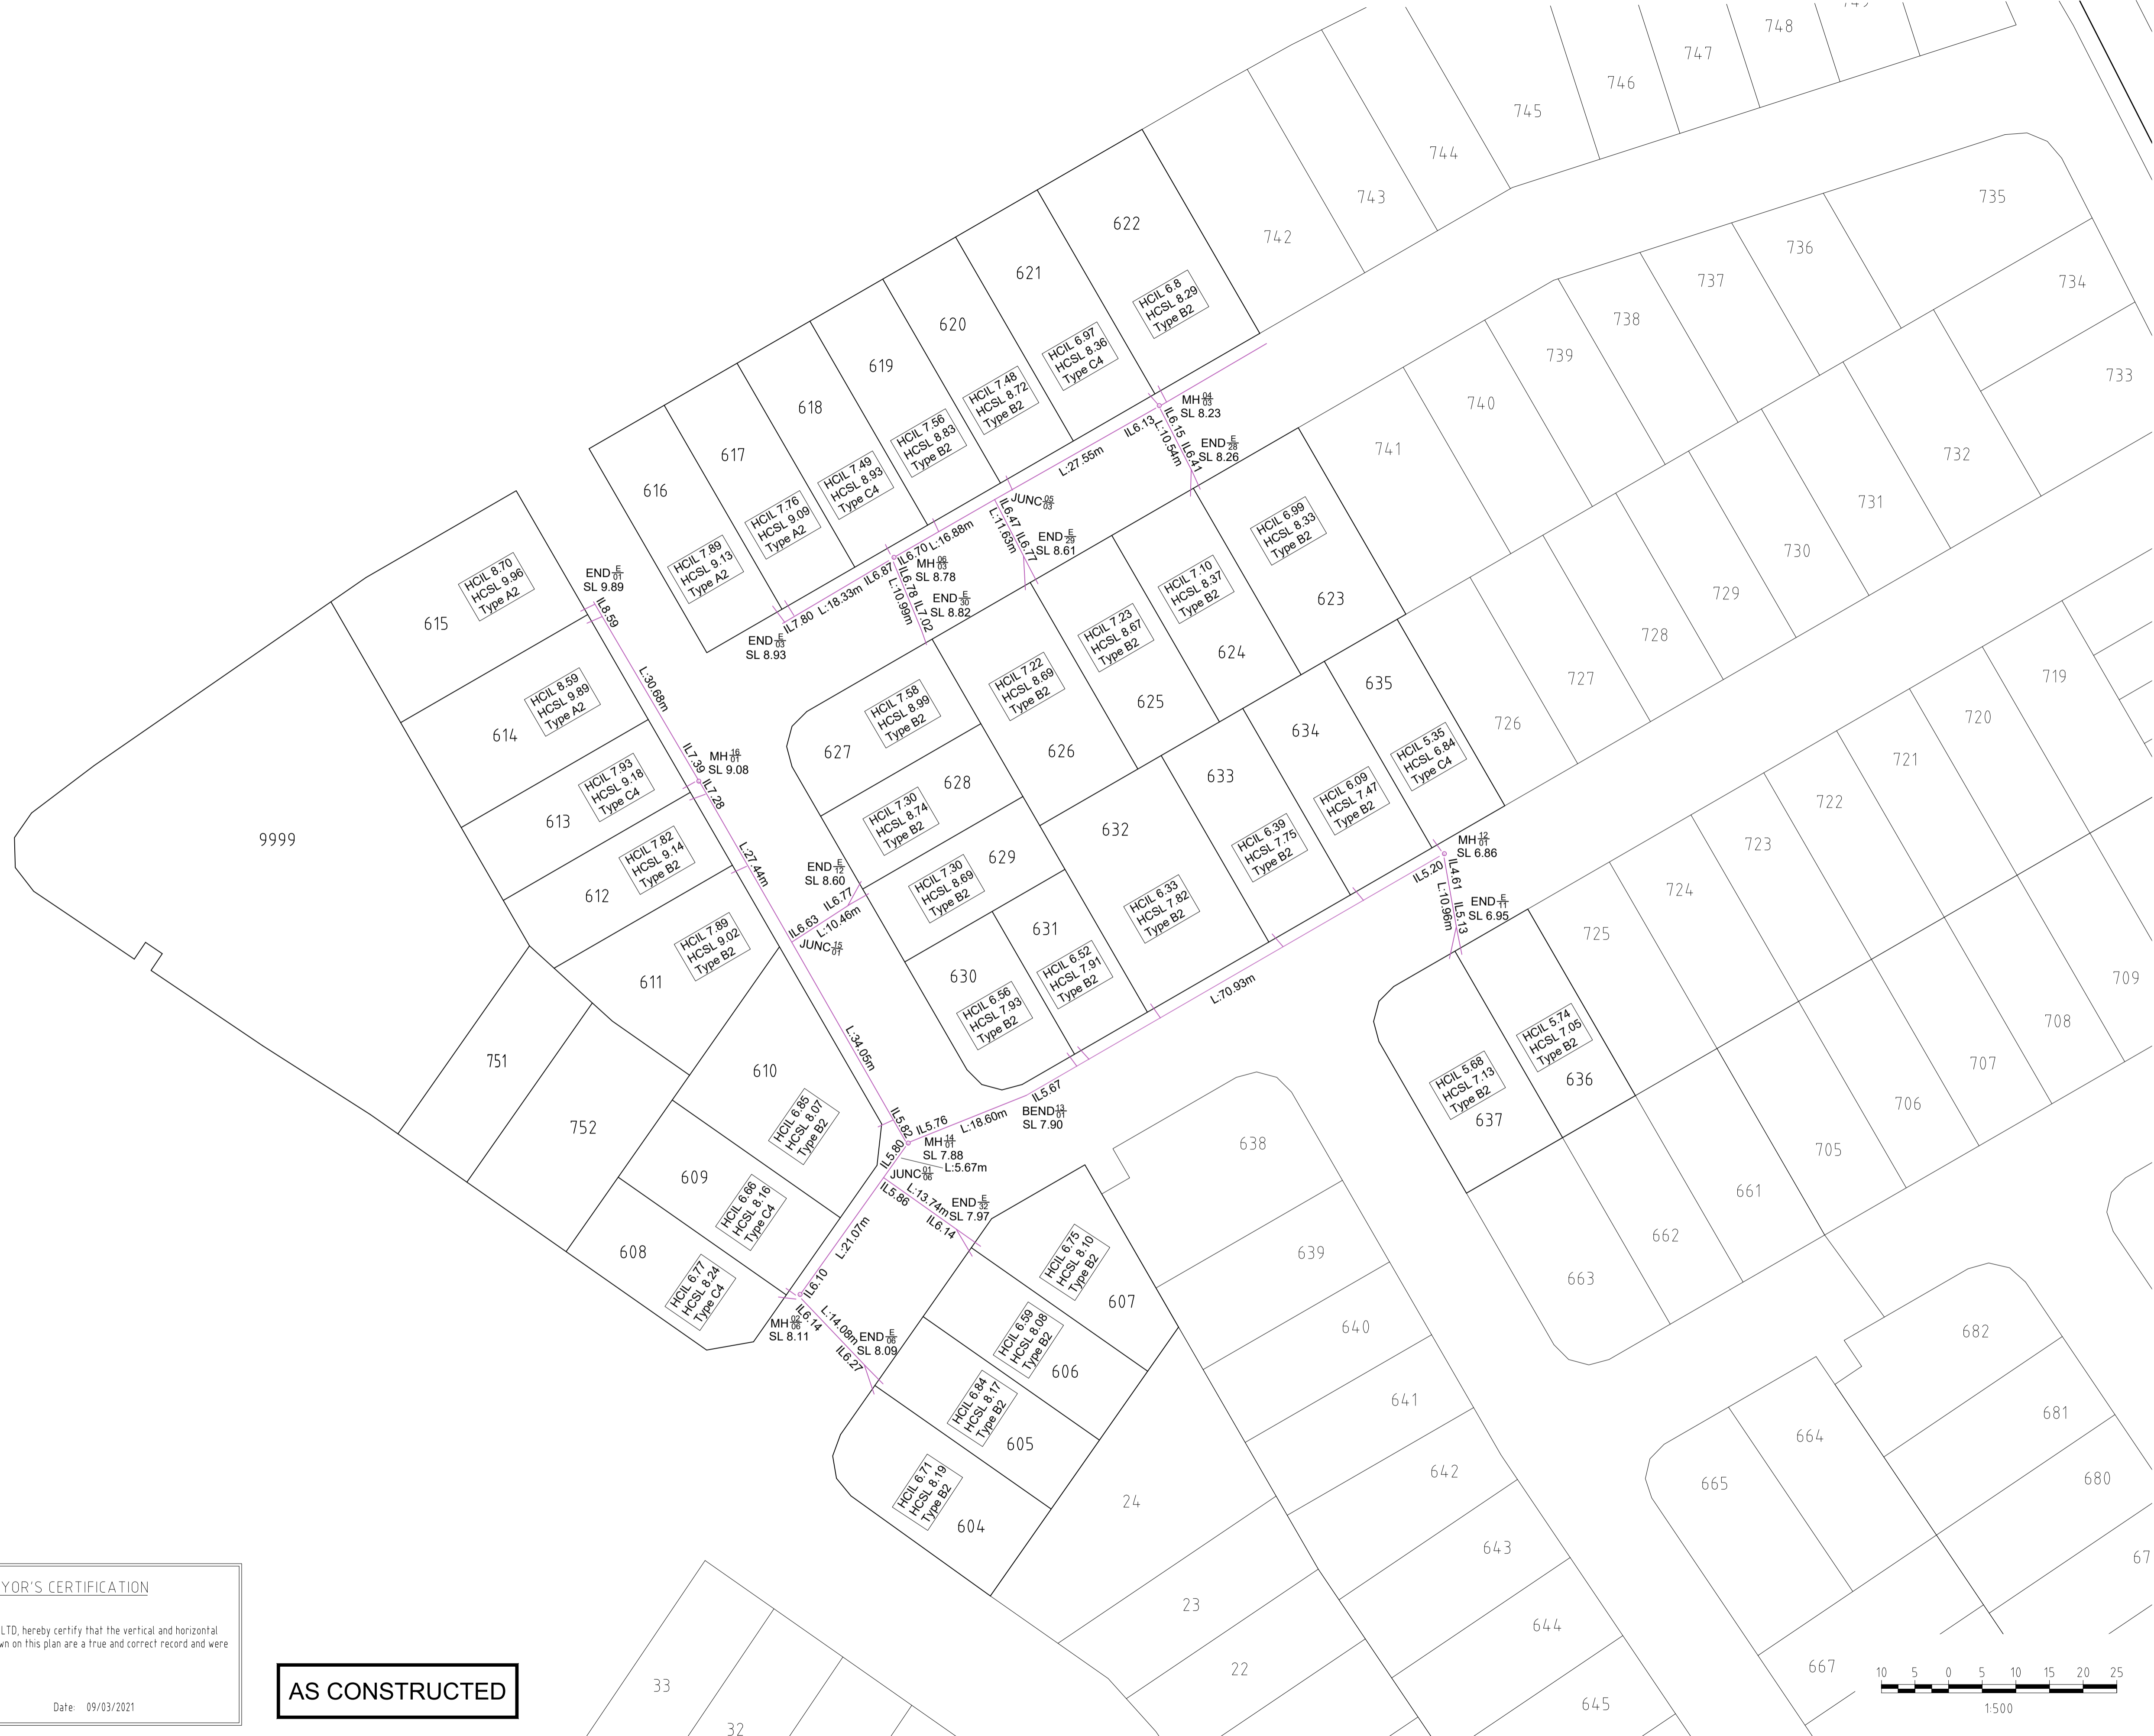

**ENGINEER'S CERTIFICATION**

I, MARK SHAW, being a certified / registered engineer and duly authorised representative of KN GROUP PTY LTD hereby:

- Certify the information contained in the drawing is an accurate "AS CONSTRUCTED" representation of the works.

- Accept responsibility for the "AS CONSTRUCTED" information contained in this drawing.

- Acknowledge the "AS CONSTRUCTED" information contained in drawing may be relied on by Council and others.

Certification by \_\_\_\_\_ on \_\_\_\_\_


for KN GROUP PTY LTD.  
Registered Professional Engineer of Queensland - No. 17544

**SURVEYOR'S CERTIFICATION**

We T.H. JENSEN BOWERS PTY LTD, hereby certify that the vertical and horizontal locations and dimensions shown on this plan are a true and correct record and were located by survey.


Director \_\_\_\_\_ Date: 09/03/2021

**AS CONSTRUCTED**

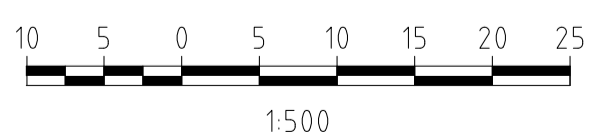

**A1**

INDEX	DATE	REVISIONS	DRAWN	CHECKED	PASSED	INITIALS	DATE
B	05/03/2021	Amend Lots 614 & 615 Finished Levels	JB	SJM	DB		23/02/2021
A	23/02/2021	Original Issue	JB	SJM	DB		09/03/2021

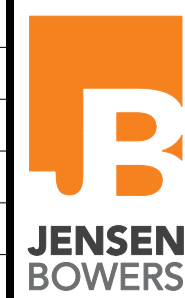

**SURVEYORS PLANNERS DEVELOPMENT ADVISORS**  
jensenbowers.com.au

72 Costin Street, Fortitude Valley, Qld 4006  
PO Box 799, Spring Hill, Qld 4004  
T (07) 3852 1771 F (07) 3252 9818  
T.H. Jensen & Bowers Pty. Ltd. (Consulting Surveyors)  
ABN: 52 010 872 607  
© Copyright reserved to Jensen Bowers Group Consultants Pty Ltd



**Unitywater**  
09/03/2021  
NORTHEAST BUSINESS PARK C/ - KN GROUP PTY LTD CONSULTING ENGINEERS  
NORTH HARBOUR - STAGE 42B  
AS CONSTRUCTED SEWER RETICULATION

SHEET 1 OF 1 SHEETS	SCALE 1:500
REVISION DATE 09/03/2021	REVISION B
DISCIPLINE CODE	
DRAWING NO. U-2021-0202	