

LEGEND

- Ø Pipe Diameter
- L Length
- IL Invert Level
- SL Surface Level
- MH Manhole
- USIL Up Stream Invert Level
- DSIL Down Stream Invert Level
- Gully Pit

ENGINEER'S CERTIFICATION

I, MARK SHAW being a certified / registered engineer and duly authorised representative of KN GROUP PTY LTD hereby:

- Certify the information contained in the drawing is an accurate "AS CONSTRUCTED" representation of the works.
- Accept responsibility for the "AS CONSTRUCTED" information contained in this drawing.
- Acknowledge the "AS CONSTRUCTED" information contained in drawing may be relied on by Council and others.


Certification by _____ on _____

for KN GROUP PTY LTD.
Registered Professional Engineer of Queensland - No. 17544

SURVEYOR'S CERTIFICATION

We TH JENSEN BOWERS PTY LTD, hereby certify that the vertical and horizontal locations and dimensions shown on this plan are a true and correct record and were located by survey.

Director _____ 02/09/2021

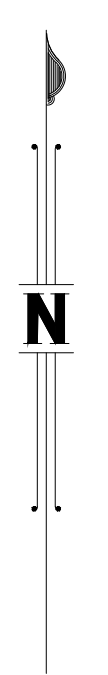

JENSEN BOWERS
SURVEYORS PLANNERS DEVELOPMENT ADVISORS
jensenbowers.com.au

72 Costin Street, Fortitude Valley, Qld. 4006
PO Box 799, Spring Hill, Qld. 4004
T (07) 3852 1771 F (07) 3252 9818

T.H. Jensen & Bowers Pty. Ltd. (Consulting Surveyors)
ABN: 52 010 872 607

© Copyright reserved to Jensen Bowers Group Consultants Pty Ltd

Associated Consultants

Local Authority: Morton Bay Regional Council
Authority Ref. No:
RP Description: Lots 74-123 on SP255895

Original Portion: 10 & 24
Date of Survey: 31/08/2021
Level Datum: AHD (der)
Origin: OPM 103504 (RL19.282)
Level Bk / Fid Bk: Digital
Horizontal Datum: MGA
Contour Interval: N/A

Scale

0 10 20 30m

1 : 500@A1 (Before Reduction)

The services shown hereon have been located where possible by field survey. Whilst due care and attention have been exercised, T.H. Jensen and Bowers Pty. Ltd. does not warrant that the services have been located in their entirety.

Disclaimer
Any licence, expressed or implied, to use this document for any purpose whatsoever is restricted to the terms of the agreement or implied agreement between Jensen Bowers and the instructing party.

Drawn: JB	Date: 02/09/2021
Surveyed: TI	Date: 31/08/2021
Checked: SM	Date: 02/09/2021

Approved: _____
SJM

Issue	Description	Date	Appd.
A	Original Issue	02/09/21	SJM

Client
NORTH HARBOUR HOLDINGS P/L

**North Harbour
Buckley Road
Burpengary East**

**As Constructed
Stormwater
Stage 25**

Drawing No.	Issue	Original Size
S-7550-305	A	A1