


NOTES

- All Sewer Main Pipes are Ø160 PE21 PE100 Class SDR21, unless noted otherwise.
- All Sewer House Connections are Ø110 PE, unless noted otherwise.

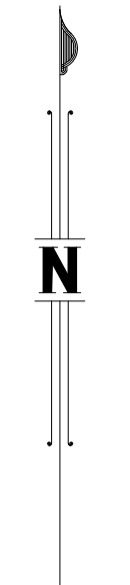

ENGINEER'S CERTIFICATION

I, MARK SHAW, being a certified / registered engineer and duly authorised representative of KN GROUP PTY LTD hereby:

- Certify the information contained in the drawing is an accurate "AS CONSTRUCTED" representation of the works.
- Accept responsibility for the "AS CONSTRUCTED" information contained in this drawing.
- Acknowledge the "AS CONSTRUCTED" information contained in drawing may be relied on by Council and others.

Certification by _____ on _____


for KN GROUP PTY LTD
Registered Professional Engineer of Queensland - No. 17544

SURVEYOR'S CERTIFICATION

We T.H. JENSEN BOWERS PTY LTD, hereby certify that the vertical and horizontal locations and dimensions shown on this plan are a true and correct record and were located by survey.

Director _____ 31/08/2021

AS CONSTRUCTED

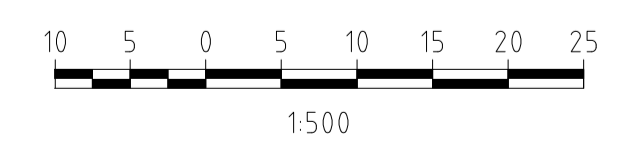

| | | | | | | |
|-----------|-------|------------|----------------|-------|---------|--------|
| A1 | A | 31/08/2021 | Original Issue | JB | SM | SM |
| | INDEX | DATE | REVISIONS | DRAWN | CHECKED | PASSED |

| | | |
|----------|----|------------|
| DRAWN | JB | 31/08/2021 |
| CHECKED | SM | 31/08/2021 |
| PASSED | SM | 31/08/2021 |
| INITIALS | | DATE |

JENSEN BOWERS

SURVEYORS PLANNERS DEVELOPMENT ADVISORS

jensenbowers.com.au

72 Costin Street, Fortitude Valley, Qld. 4006
PO Box 799, Spring Hill, Qld. 4004
T 071 3852 1774 F 071 3252 9818
T.H. Jensen & Bowers Pty. Ltd. (Consulting Surveyors)
ABN: 52 010 872 607



Unitywater

NORTHEAST BUSINESS PARK C/ - KN GROUP PTY LTD CONSULTING ENGINEERS
NORTH HARBOUR - STAGE 25
AS CONSTRUCTED SEWER RETICULATION

| | |
|-------------------------------|-------------|
| SHEET 1 OF 1 SHEETS | SCALE 1:500 |
| REVISION DATE 31/08/2021 | REVISION A |
| DRAWING NO. U-<TBA ENGINEERS> | |