


LEGEND

- ∅ Pipe Diameter
- Fire Hydrant
- Temporary Hydrant/End
- ⊗ Valve
- ① 11.25° BEND
- ② 22.5° BEND
- ③ 45° BEND
- ④ 90° BEND
- ⊕ Ready Tap
- Water Meter
- Water Crossing
- Water Main
- DICL Water Main

NOTES

- Water main pipes are Ø150 PVC-0 Class PN16 unless noted otherwise.
- All road crossings are Ø150 DICL Class DN35 unless noted otherwise.

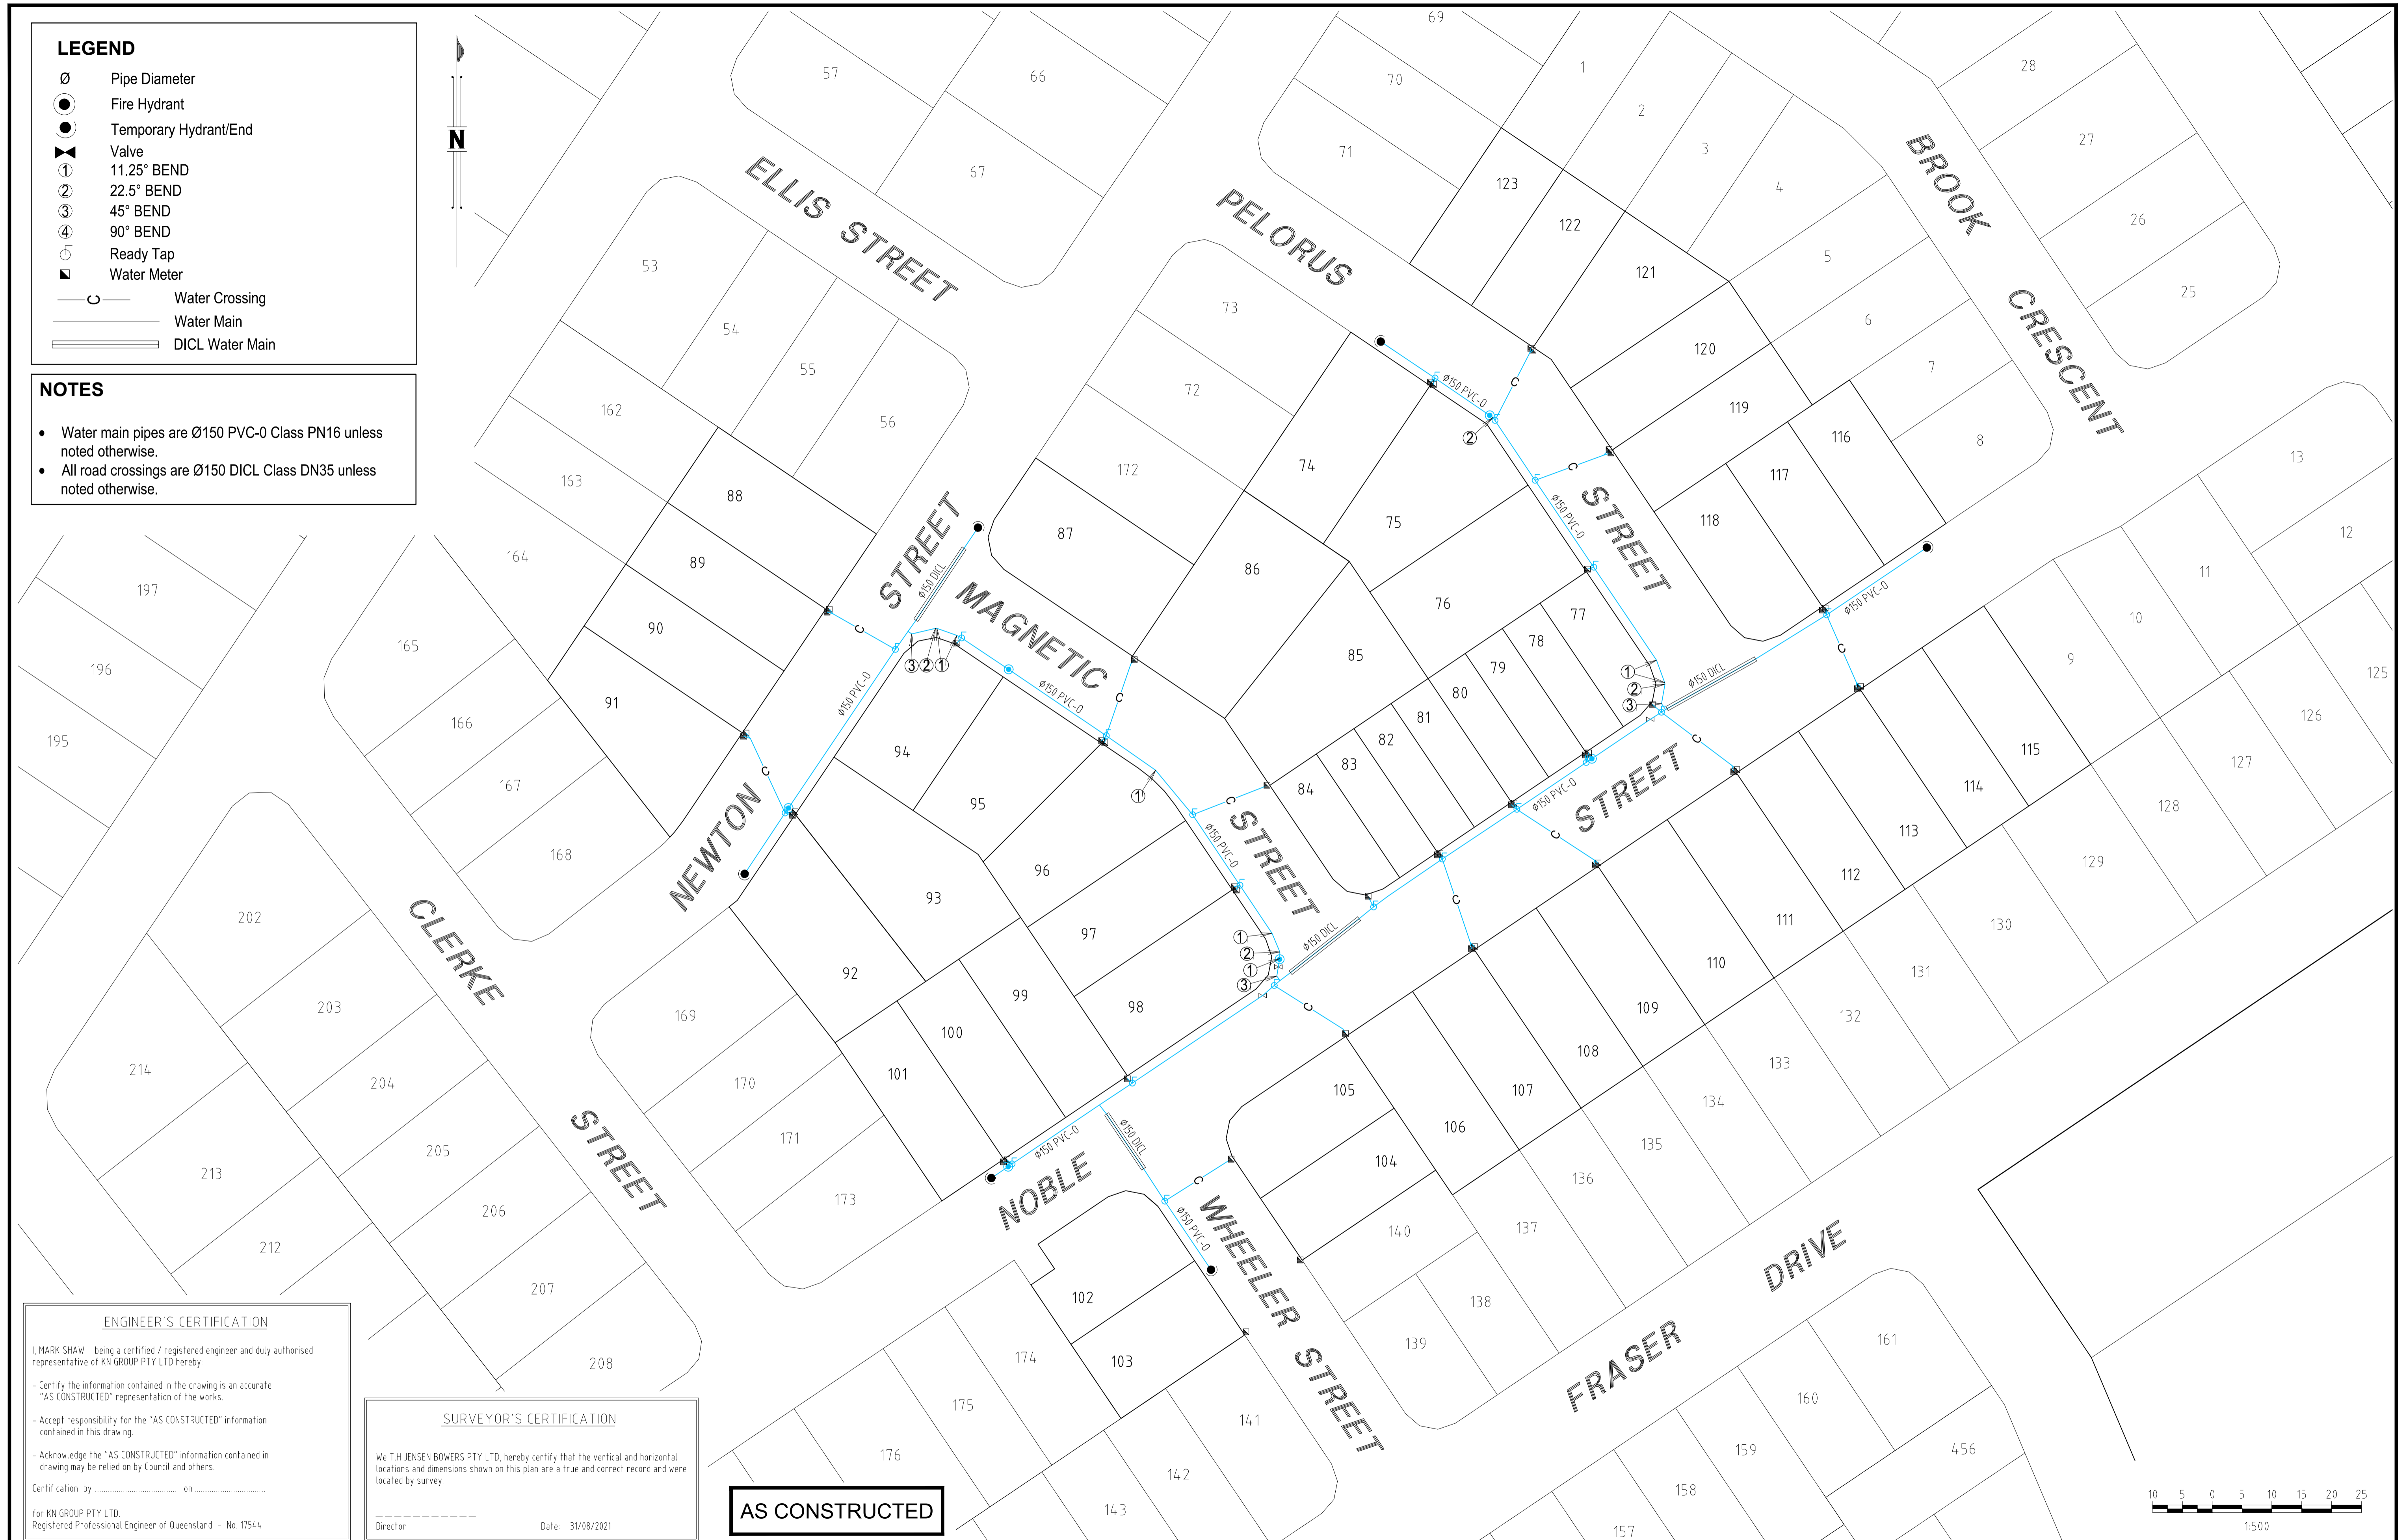

ENGINEER'S CERTIFICATION

I, MARK SHAW being a certified / registered engineer and duly authorised representative of KN GROUP PTY LTD hereby:

- Certify the information contained in the drawing is an accurate "AS CONSTRUCTED" representation of the works.
- Accept responsibility for the "AS CONSTRUCTED" information contained in this drawing.
- Acknowledge the "AS CONSTRUCTED" information contained in drawing may be relied on by Council and others.

Certification by _____ on _____


for KN GROUP PTY LTD.
Registered Professional Engineer of Queensland - No. 17544

SURVEYOR'S CERTIFICATION

We T.H. JENSEN BOWERS PTY LTD, hereby certify that the vertical and horizontal locations and dimensions shown on this plan are a true and correct record and were located by survey.

Director _____ Date: 31/08/2021

AS CONSTRUCTED

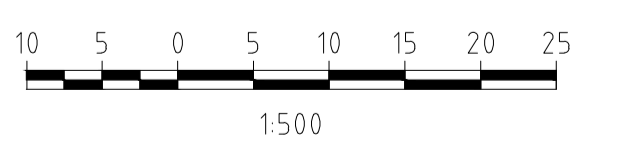

A1	A	31/08/2021	Original Issue	JB	SJM	DB
	INDEX	DATE	REVISIONS	DRAWN	CHECKED	PASSED

DRAWN	JB	31/08/2021
CHECKED	SJM	31/08/2021
PASSED	DB	31/08/2021
INITIALS	DATE	

JENSEN BOWERS

SURVEYORS
PLANNERS
DEVELOPMENT ADVISORS

jensenbowers.com.au

72 Coatin Street, Fortitude Valley, Qld 4006
PO Box 790, Spring Hill, Qld 4004
T 071 3852 1771 F 071 3852 9818
T.H. Jensen & Bowers Pty. Ltd. (Consulting Surveyors)
ABN: 52 010 872 607
© Copyright reserved to Jensen Bowers Group Consultants Pty Ltd



Unitywater

31/08/2021

NORTHEAST BUSINESS PARK C/ - KN GROUP PTY LTD CONSULTING ENGINEERS
NORTH HARBOUR - STAGE 25
AS CONSTRUCTED WATER RETICULATION

SHEET 1 OF 1 SHEETS	SCALE 1:500
REVISION DATE 31/08/2021	REVISION A
DISCIPLINE CODE	
DRAWING NO. U-2020-1130	