


- NOTES**
- All Sewer Main Pipes are Ø160 PE21 PE100 Class SDR21, unless noted otherwise.
 - All Sewer House Connections are Ø110 PE, unless noted otherwise.

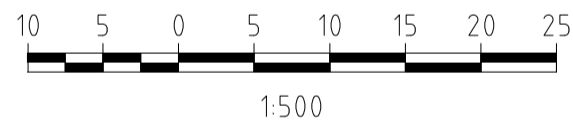

AS CONSTRUCTED

SURVEYOR'S CERTIFICATION

We, T.H. JENSEN BOWERS PTY LTD, hereby certify that the vertical and horizontal locations and dimensions shown on this plan are a true and correct record and were located by survey.

Director _____ 9/07/2021

ENGINEER'S CERTIFICATION

I, MARK SHAW, being a certified / registered engineer and duly authorised representative of KN GROUP PTY LTD hereby:

- Certify the information contained in the drawing is an accurate "AS CONSTRUCTED" representation of the works.
- Accept responsibility for the "AS CONSTRUCTED" information contained in this drawing.
- Acknowledge the "AS CONSTRUCTED" information contained in drawing may be relied on by Council and others.

Certification by _____ on _____

for KN GROUP PTY LTD.
Registered Professional Engineer of Queensland - No. 17544

A1	INDEX	DATE	REVISIONS	DRAWN	CHECKED	PASSED
	A	22/07/2021	Original Issue	JB	SM	SM

DRAWN	JB	9/07/2021
CHECKED	SM	9/07/2021
PASSED	SM	9/07/2021
INITIALS		DATE

JENSEN BOWERS
SURVEYORS PLANNERS DEVELOPMENT ADVISORS
jensenbowers.com.au

72 Costin Street, Fortitude Valley, Qld. 4006
PO Box 789, Spring Hill, Qld. 4004
T: (07) 3852 1771 F: (07) 3252 9818
T.H. Jensen & Bowers Pty. Ltd. (Consulting Surveyors)
ABN: 52 010 872 607
© Copyright reserved to Jensen Bowers Group Consultants Pty Ltd



Unitywater

NORTHEAST BUSINESS PARK C/ - KN GROUP PTY LTD CONSULTING ENGINEERS
NORTH HARBOUR - STAGE 26
AS CONSTRUCTED SEWER RETICULATION

SHEET 1 OF 1 SHEETS	SCALE 1:500
REVISION DATE 9/07/2021	REVISION A
DRAWING NO. U-<TBA ENGINEERS>	