




LEGEND

- Ø Pipe Diameter
- Fire Hydrant
- Temporary Hydrant/End
- ⊗ Valve
- ① 11.25° BEND
- ② 22.5° BEND
- ③ 45° BEND
- ④ 90° BEND
- ⊕ Ready Tap
- Water Meter
- Water Crossing
- Water Main
- === DICL Water Main

- NOTES**
- Water main pipes are Ø150 PVC-0 Class PN16 unless noted otherwise.
 - All road crossings are Ø150 DICL Class DN35 unless noted otherwise.

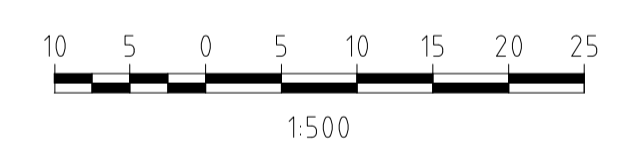

AS CONSTRUCTED

SURVEYOR'S CERTIFICATION

We T.H. JENSEN BOWERS PTY LTD, hereby certify that the vertical and horizontal locations and dimensions shown on this plan are a true and correct record and were located by survey.

Director: _____ Date: 08/09/2021

ENGINEER'S CERTIFICATION

I, MARK SHAW being a certified / registered engineer and duly authorised representative of KN GROUP PTY LTD hereby:

- Certify the information contained in the drawing is an accurate "AS CONSTRUCTED" representation of the works.
- Accept responsibility for the "AS CONSTRUCTED" information contained in this drawing.
- Acknowledge the "AS CONSTRUCTED" information contained in drawing may be relied on by Council and others.

Certification by _____ on _____

For KN GROUP PTY LTD.
Registered Professional Engineer of Queensland - No. 17544

A1	01/09/2021	Original Issue	JB	SJM	DB
	INDEX	DATE	REVISIONS	DRAWN	CHECKED

DRAWN	JB	01/09/2021
CHECKED	SJM	01/09/2021
PASSED	DB	01/09/2021
INITIALS	DATE	

**SURVEYORS
PLANNERS
DEVELOPMENT ADVISORS**
jensenbowers.com.au

72 Cosin Street, Fortitude Valley, Qld. 4006
 PO Box 780, Spring Hill, Qld. 4004
 T: (07) 3852 1771 F: (07) 3252 9818
 T.H. Jensen & Bowers Pty. Ltd. (Consulting Surveyors)
 ABN: 52 010 812 607
© Copyright reserved to Jensen Bowers Group Consultants Pty Ltd



Unitywater

01/09/2021
 NORTH EAST BUSINESS PARK C/ - KN GROUP PTY LTD CONSULTING ENGINEERS
 NORTH HARBOUR - STAGE 26
 AS CONSTRUCTED WATER RETICULATION

SHEET 1 OF 1 SHEETS	SCALE 1:500
REVISION DATE 01/09/2021	REVISION A
DISCIPLINE CODE	
DRAWING NO. U-2020-1130	