

PSM 724.18
 E: 498714.197
 N: 6999186.146
 RL: 14.859m



UNITYWATER PROJECT NUMBER 2016009402S28

Stage 28, North Harbour Estate

WATER MAIN



| DRAWING INDEX | |
|----------------|---------------------------------|
| DRAWING NUMBER | DESCRIPTION |
| U-2021-3845 | LOCALITY PLAN AND DRAWING INDEX |

COORDINATE DATUM NOTE:
 HORIZONTAL COORDINATES(E,N) SUPPLIED ARE MAPPING GRID OF AUSTRALIA(MGA), ZONE 56 BASED ON THE UNIVERSAL TRANSVERSE MERCATOR PROJECTION AND THE GEOCENTRIC DATUM OF AUSTRALIA 1994.

ENGINEER'S CERTIFICATION


I, Mark Shaw, of KN GROUP PTY LTD, hereby certify that:
 1. The information contained in this drawing / document is in compliance with approved drawings and design.
 2. The new water and sewerage works defined by this drawing have been designed and constructed in accordance with the SEQ Code.
 3. This represents an accurate record of as-constructed works
 4. I accept responsibility for the information contained in this drawing / document.

Mark Shaw
 RPEQ (signature) RPEQ No. 17544 Date: _____

REGISTERED SURVEYOR'S CERTIFICATION

We, T.H. JENSEN BOWERS PTY LTD, hereby certify that the vertical and horizontal locations and dimensions shown on this plan are a true and correct record and were located by survey.

T.H. Jensen & Bowers Pty Ltd
 Registered Surveyor (sig) Reg. Surveyor No. 3756 Date: 08/07/22

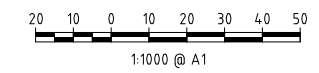


AS CONSTRUCTED

| | | | | | | | | | | | | |
|-----------|-------|------|-----------|-------|---------|--------|----------|------|--|--|--------------------------|-------------------|
| A1 | INDEX | DATE | REVISIONS | DRAWN | CHECKED | PASSED | INITIALS | DATE | <small>72 Costin Street, Fortitude Valley, Qld. 4006 PO Box 790, Spring Hill, Qld. 4004 T (07) 3852 1771 F (07) 3852 9818 T.H. Jensen & Bowers Pty. Ltd. (Consulting Surveyors) ABN: 52 010 872 657 © Copyright reserved to Jensen Bowers Group Consultants Pty Ltd</small> | Unitywater 2016009402S28 North Harbour Stage 28 | SHEET 1 OF 2 SHEETS | SCALE 1:1000 |
| | | | | | | | | | | | REVISION DATE 08-07-2022 | REVISION A |

- LEGEND**
- ∅ Pipe Diameter
 - Fire Hydrant
 - Temporary Hydrant/End
 - ⊗ Valve
 - ① 11.25° BEND
 - ② 22.5° BEND
 - ③ 45° BEND
 - ④ 90° BEND
 - ⊕ Ready Tap
 - Water Meter
 - Water Crossing
 - Water Main
 - DICL Water Main

- NOTES**
- Water main pipes are Ø150 PVC-0 Class PN16 unless noted otherwise.
 - All road crossings are Ø150 DICL Class DN35 unless noted otherwise.

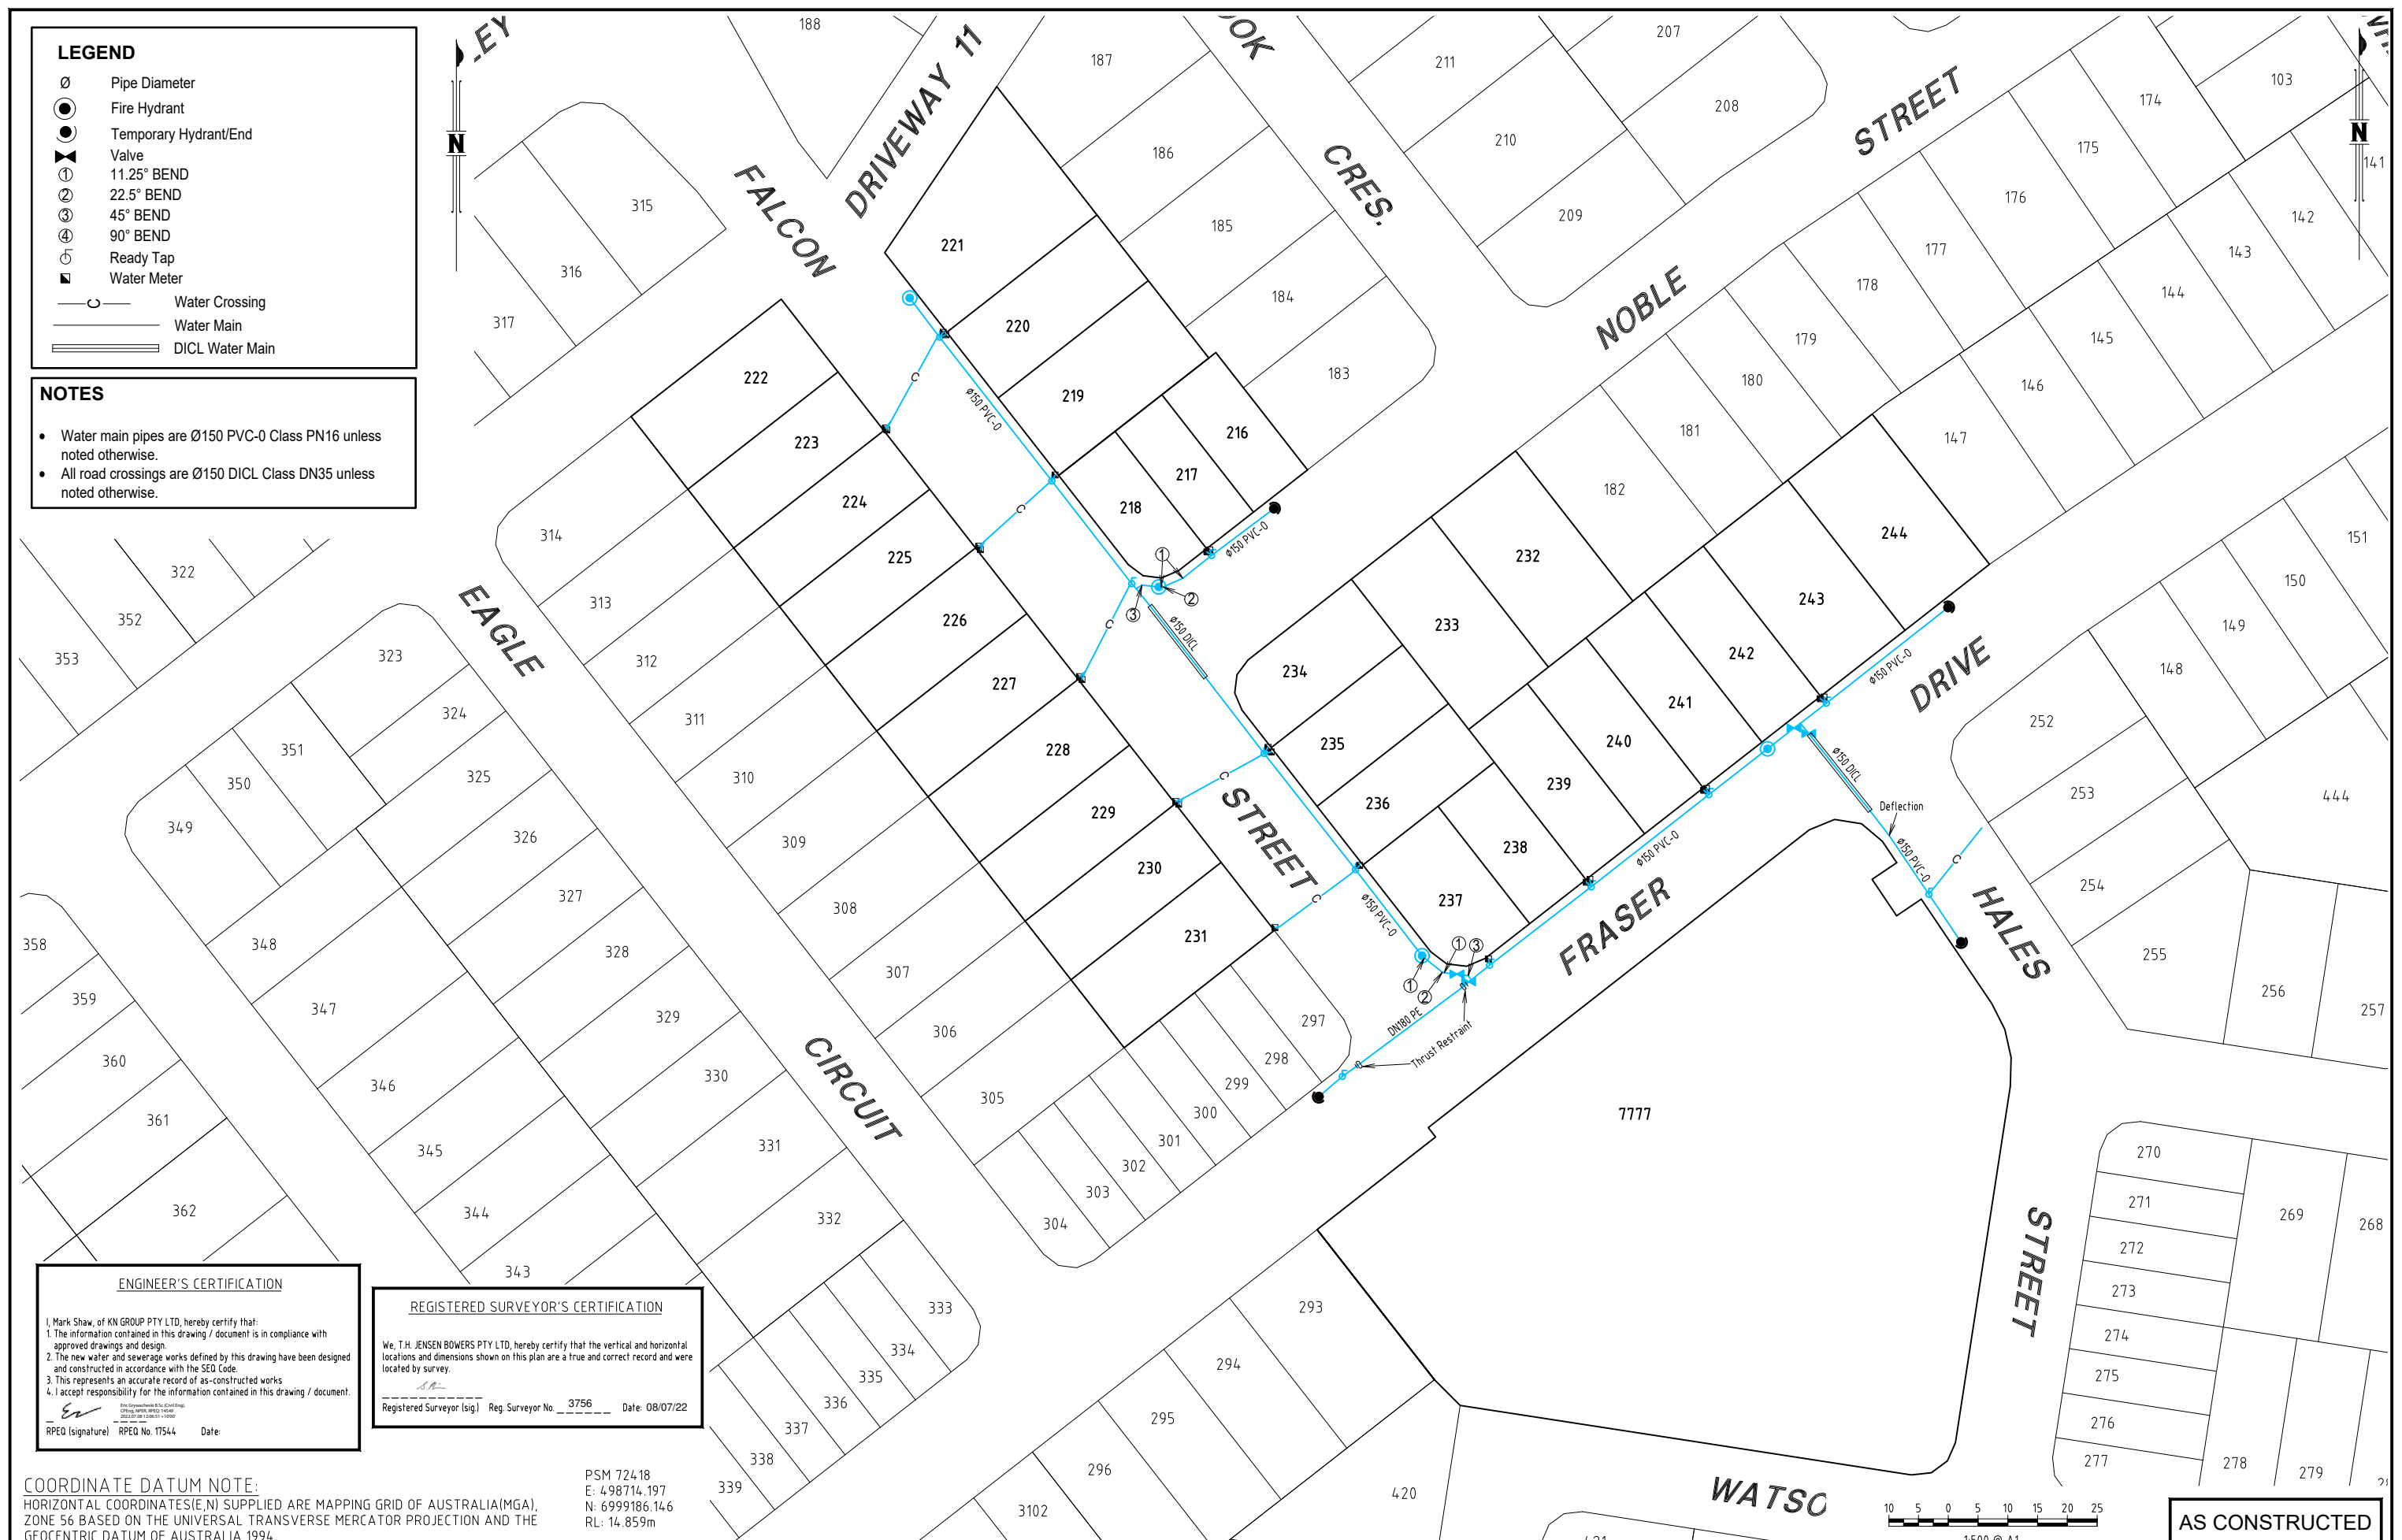

ENGINEER'S CERTIFICATION

I, Mark Shaw, of KN GROUP PTY LTD, hereby certify that:

- The information contained in this drawing / document is in compliance with approved drawings and design.
- The new water and sewerage works defined by this drawing have been designed and constructed in accordance with the SEQ Code.
- This represents an accurate record of as-constructed works.
- I accept responsibility for the information contained in this drawing / document.

RPEQ (signature) RPEQ No. 17544 Date: _____


REGISTERED SURVEYOR'S CERTIFICATION

We, T.H. JENSEN BOWERS PTY LTD, hereby certify that the vertical and horizontal locations and dimensions shown on this plan are a true and correct record and were located by survey.

Registered Surveyor (sig) Reg. Surveyor No. 3756 Date: 08/07/22

COORDINATE DATUM NOTE:
HORIZONTAL COORDINATES(E,N) SUPPLIED ARE MAPPING GRID OF AUSTRALIA(MGA), ZONE 56 BASED ON THE UNIVERSAL TRANSVERSE MERCATOR PROJECTION AND THE GEOCENTRIC DATUM OF AUSTRALIA 1994.

PSM 724.18
E: 498714.197
N: 6999186.146
RL: 14.859m

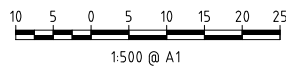

AS CONSTRUCTED

| | | | | | | |
|----|-------|------------|----------------|-------|---------|--------|
| A1 | A | 08/07/2022 | Original Issue | JB | SJM | DB |
| | INDEX | DATE | REVISIONS | DRAWN | CHECKED | PASSED |

| | | | |
|---------|-----|------------|---|
| DRAWN | JB | 08/07/2022 | <p>JENSEN BOWERS SURVEYORS PLANNERS DEVELOPMENT ADVISORS jensenbowers.com.au</p> |
| CHECKED | SJM | 08/07/2022 | |
| PASSED | DB | 08/07/2022 | |



Unitywater
2016009402S28
North Harbour Stage 28

| | |
|--------------------------|-------------|
| SHEET 2 OF 2 SHEETS | SCALE 1:500 |
| REVISION DATE 08-07-2022 | REVISION A |
| DISCIPLINE CODE C | |
| DRAWING NO. U-2021-3845 | |