


**LEGEND**

- ∅ Pipe Diameter
- Fire Hydrant
- Temporary Hydrant/End
- ⊘ Valve
- ① 11.25° BEND
- ② 22.5° BEND
- ③ 45° BEND
- ④ 90° BEND
- ⊕ Ready Tap
- ⊖ Water Meter
- Water Crossing
- Water Main
- DICL Water Main

**NOTES**

- Water main pipes are Ø150 PVC-0 Class PN16 unless noted otherwise.
- All road crossings are Ø150 DICL Class DN35 unless noted otherwise.

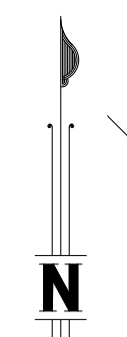

**ENGINEER'S CERTIFICATION**

I, MARK SHAW, being a certified / registered engineer and duly authorised representative of KN GROUP PTY LTD hereby:

- Certify the information contained in the drawing is an accurate "AS CONSTRUCTED" representation of the works.
- Accept responsibility for the "AS CONSTRUCTED" information contained in this drawing.
- Acknowledge the "AS CONSTRUCTED" information contained in drawing may be relied on by Council and others.

Certification by \_\_\_\_\_ on \_\_\_\_\_


for KN GROUP PTY LTD.  
Registered Professional Engineer of Queensland - No. 17544

**SURVEYOR'S CERTIFICATION**

We T.H. JENSEN BOWERS PTY LTD, hereby certify that the vertical and horizontal locations and dimensions shown on this plan are a true and correct record and were located by survey.

Director: *[Signature]* Date: 15/02/2021

**AS CONSTRUCTED**

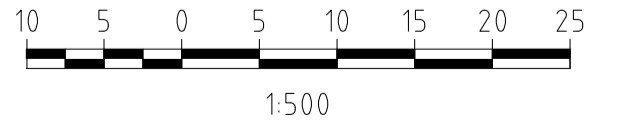

A1	INDEX	DATE	REVISIONS	DRAWN	CHECKED	PASSED
	A	29/01/2021	Original Issue	JB	SJM	DB

DRAWN	JB	29/01/2021
CHECKED	SJM	29/01/2021
PASSED	DB	29/01/2021
INITIALS	DATE	

**JENSEN BOWERS**

72 Costin Street, Fortitude Valley, Qld 4006  
 PO Box 799, Spring Hill, Qld 4004  
 T (07) 3852 1771 F (07) 3252 9818  
 T.H. Jensen & Bowers Pty. Ltd. (Consulting Surveyors)  
 ABN: 52 010 872 607  
 © Copyright reserved to Jensen Bowers Group Consultants Pty Ltd



**Unitywater**

29/01/2021  
 NORTHEAST BUSINESS PARK C/ - KN GROUP PTY LTD CONSULTING ENGINEERS  
 NORTH HARBOUR - STAGE 43  
 AS CONSTRUCTED WATER RETICULATION

SHEET 1 OF 1 SHEETS	SCALE 1:500
REVISION DATE 29/01/2021	REVISION A
DISCIPLINE CODE	
DRAWING NO. U-2021-0129	